

Name

Service No. 535

Address

29 Charles St.

#5754

Location

29 Charles St.

Kind of Pipe

Size

Size of Main

Repair

Renewal

New Service

ARLEX

Location

Date

Material

Amount

Total

Date

Amount

11/24/99 23'

3/4" COPPER
1" MALE TO 1" COMP
BUFFLO BOX

1939

3/4 COPPER
CURB 3/4 ARLEX 1" IRON
3/4 LLADPT

Labor

DATE _____

TOWN OF LEXINGTON—BOARD OF PUBLIC WORKS

WATER DIVISION

The undersigned applies for a supply of water at No. _____ St. and hereby agrees to comply with the rules and regulations as now, or at any future time, established by the Board of Selectmen.

Am't. of Estimate \$ _____


Owner A. H. Andresen.

Am't. Paid \$ _____

Address 29 ~~to~~ Charles St.

Builder _____

Sketch of Service Here

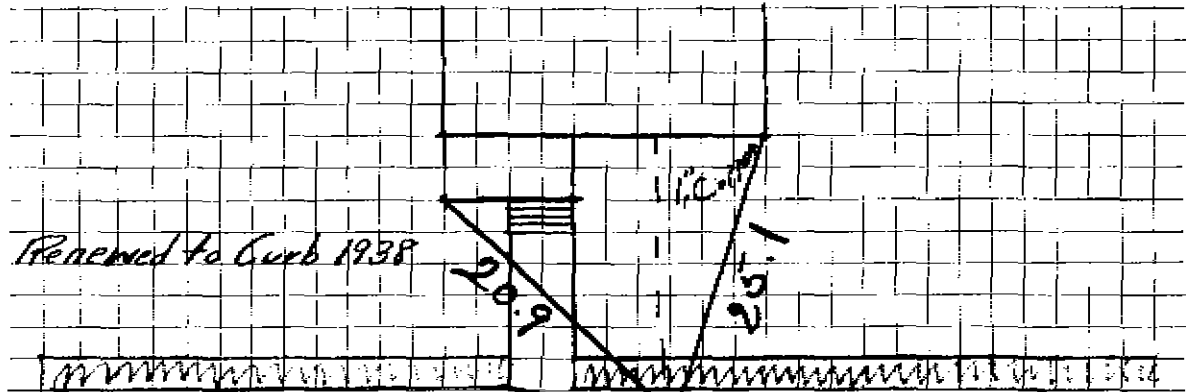

Connection made in _____ 10.7 Street. 3/4 Copper Work completed _____ 19

Remarks: