

Name

Service No. 536

Address

30 Charles St

#1828

Location 30 Charles St.

Kind of Pipe

Size

Size of Main

Repair—Renewal—New Service

Location

Date

Material

Amount

Total

Date

Amount

Labor

TOWN OF LEXINGTON—BOARD OF PUBLIC WORKS
WATER DIVISION

The undersigned applies for a supply of water at No. _____ St. and hereby agrees to comply with the rules and regulations as now, or at any future time, established by the Board of Selectmen.

Am't. of Estimate \$ _____


Owner Mr E. Boyce.

Am't. Paid \$ _____

Address 30 ~~#~~ Charles St.

Builder _____

Sketch of Service Here

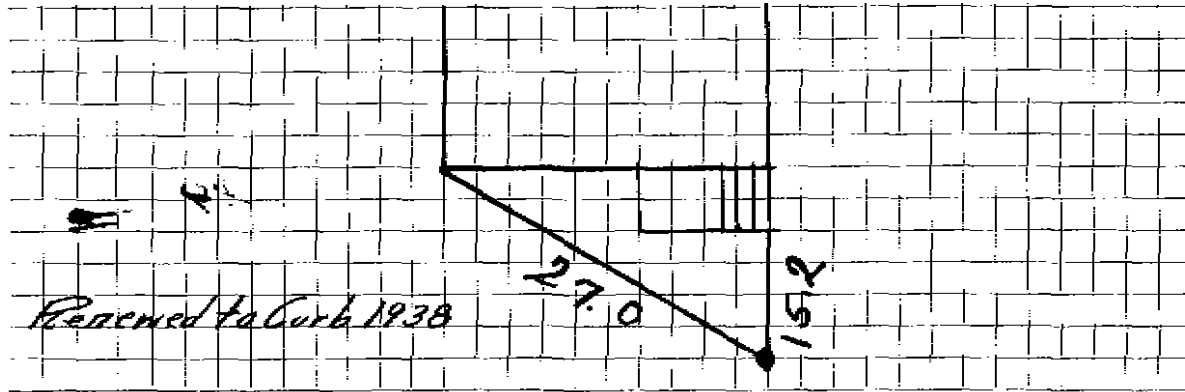

Connection made in _____ Street. Work completed _____ 19

Remarks: