

Name Joseph N. McDonald

Service No. ~~72~~ 538  
#4183

Address 31 Porter Rd., Waltham  
23 + 24 Charles St.

Location Lots 23 & 24, Charles St. #36

Kind of Pipe

Size

Size of Main

~~Repair - Renewal~~ - New Service

Location

Date	Material	Amount	Total	Date	Amount
P. 12-22-31 for 38.68	34 1" C.L. Pipe @.27	9 18			
	2 1" L.L. Coup. @.30	60			
	1 1" Br. Sp. Nipple	25			
	1 S & W Trucking	3 00 75	13 78		
10/27/31	42 Hrs. Labor @.55	23 10			
	3 " " @.60	1 80	24 90		
			38 68	Oct. 14 1931 - Cash	38 68
	Labor				

Hadley  
Prebs, Inc.,  
Oxington

DATE 10-14-31

# TOWN OF LEXINGTON—BOARD OF PUBLIC WORKS

## WATER DIVISION #36

The undersigned applies for a supply of water at No. Lots # 234 24 Charles St. and hereby agrees to comply with the rules and regulations as now, or at any future time, established by the Board of Selectmen.

Am't. of Estimate \$ \_\_\_\_\_

Owner


Am't. Paid \$ 50.00

Address

Joseph J MacDonnell  
31 Porter Rd  
Waltham

Builder \_\_\_\_\_

Sketch of Service Here

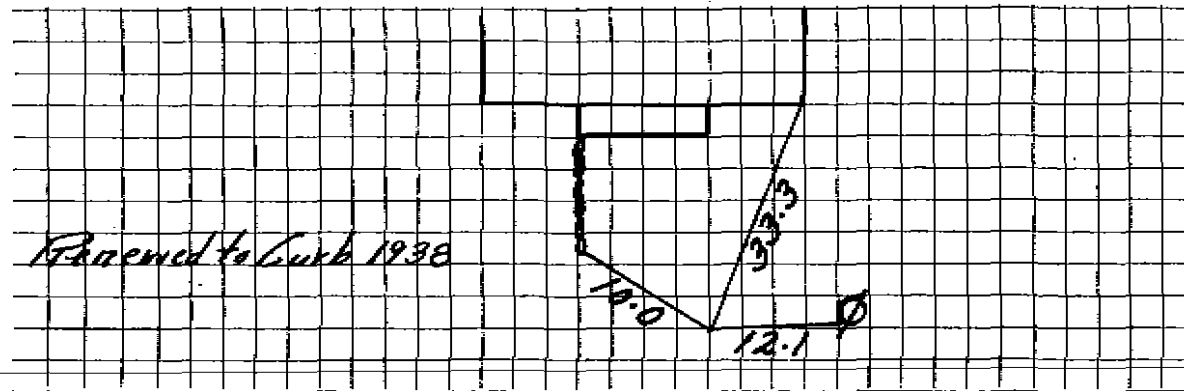

Connection made in \_\_\_\_\_ Street.

Work completed \_\_\_\_\_ 19

Remarks: