

Name Charles D. MacGillivray

Service No. 205

Address 33 Charles Street  
Lexington, Mass.

Location 33 Charles Street

Kind of Pipe

Size

Size of Main

~~Repair~~ ~~Renewal~~ New Service

Com. 11-6-50

Location

Date	Material	Amount	Total	Date	Amount	
Aug. 22, '50	Labor	1 50	1 50	<i>Aug 7 '50</i>	<i>Deposited</i>	15 00
	10% Overhead		15	<i>11-9 '50</i>	<i>Deposited</i>	2 16
	26' - 3/4" Copper Tubing @.275		7 15		No Charge	12 84
	1 - 3/4" C x 1/2" I.W.H. S&W		3 29	Aug. 22, '50	Labor	12 23
	Trucking 1 hr. @.75		75			
			12 84			
	Trench dug by owner					
	Labor					

Hadley Press, Inc., Lexington

DATE \_\_\_\_\_

# TOWN OF LEXINGTON—BOARD OF PUBLIC WORKS

## WATER DIVISION

The undersigned applies for a supply of water at No. \_\_\_\_\_ St. and hereby agrees to comply with the rules and regulations as now, or at any future time, established by the Board of Selectmen.

Am't. of Estimate \$ \_\_\_\_\_

Owner \_\_\_\_\_


Am't. Paid \$ \_\_\_\_\_

Address \_\_\_\_\_

Builder \_\_\_\_\_

*33 CHARLES*

Sketch of Service Here

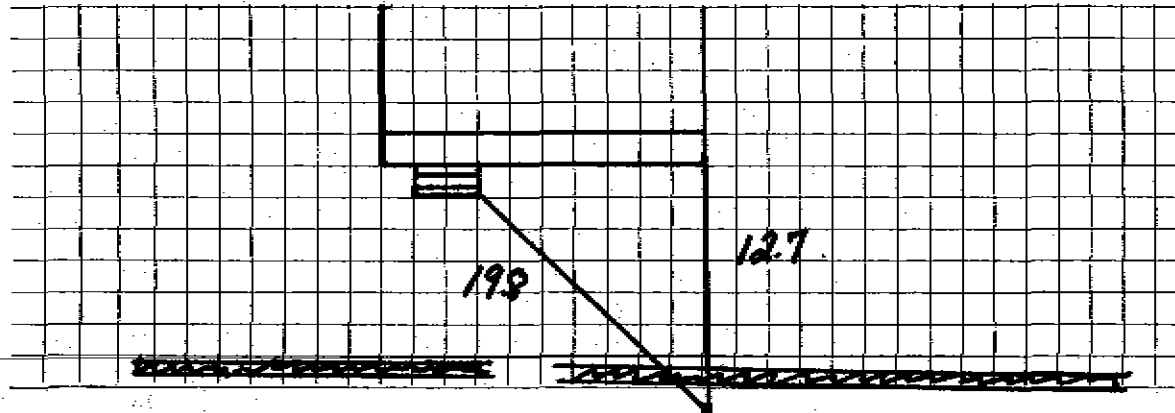

Connection made in \_\_\_\_\_

Street.

Work completed \_\_\_\_\_

19 \_\_\_\_\_

Remarks: