

WATER SERVICE RECORD

Name Donald MacGilvray

Service No. 164

Address 37 Charles Street

458

Location

~~XXXXXXXXXX~~ - New Service

Comm 12-4-61


Date	Material	Amount	Total	Date	Material	Amount
10/23/61	Labor	2 04		10-18-61	Deposit	50 00
	10% O.H.	20	2 24	12-4-61	Retard	18 47
	55' 3/4" Copper Tubing @ .42		23 10			31 51
	1 3/4" C x 1/2 IWH Stop & Waste		6 17	10/23/61	Labor	1 69
			31 51		10' 3/4" Copper Tubings @.42	4 20
					1 3/4" C Corp Cock	4 91
					1 3/4" C Curb Cock	6 28
					1 Bow & Rod	4 90
					1 1/2 Straight Tailpiece	50
					1 1/2 Offset Tailpiece	50
						22 98

DATE _____

TOWN OF LEXINGTON — BOARD OF PUBLIC WORKS

WATER DIVISION

Sketch of Service Here

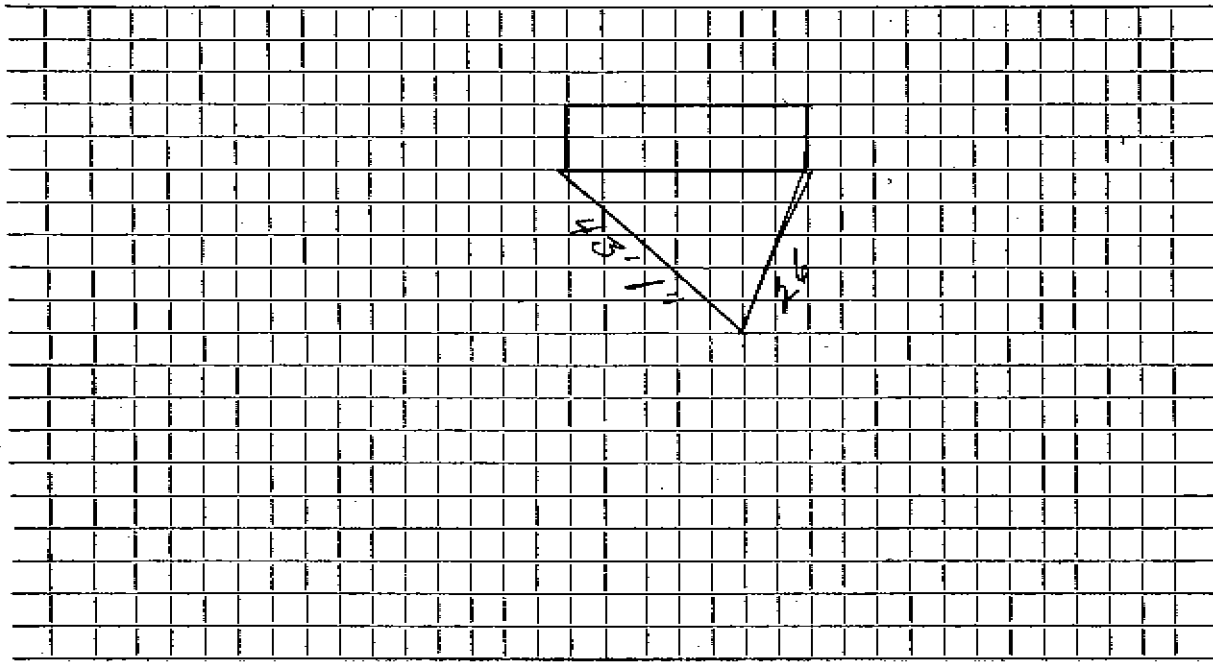

Connection made in Street. Work completed

Remarks:
.....
.....