




DATE 10/12/95

TOWN OF LEXINGTON — BOARD OF PUBLIC WORKS

WATER DIVISION

Sketch of Service Here

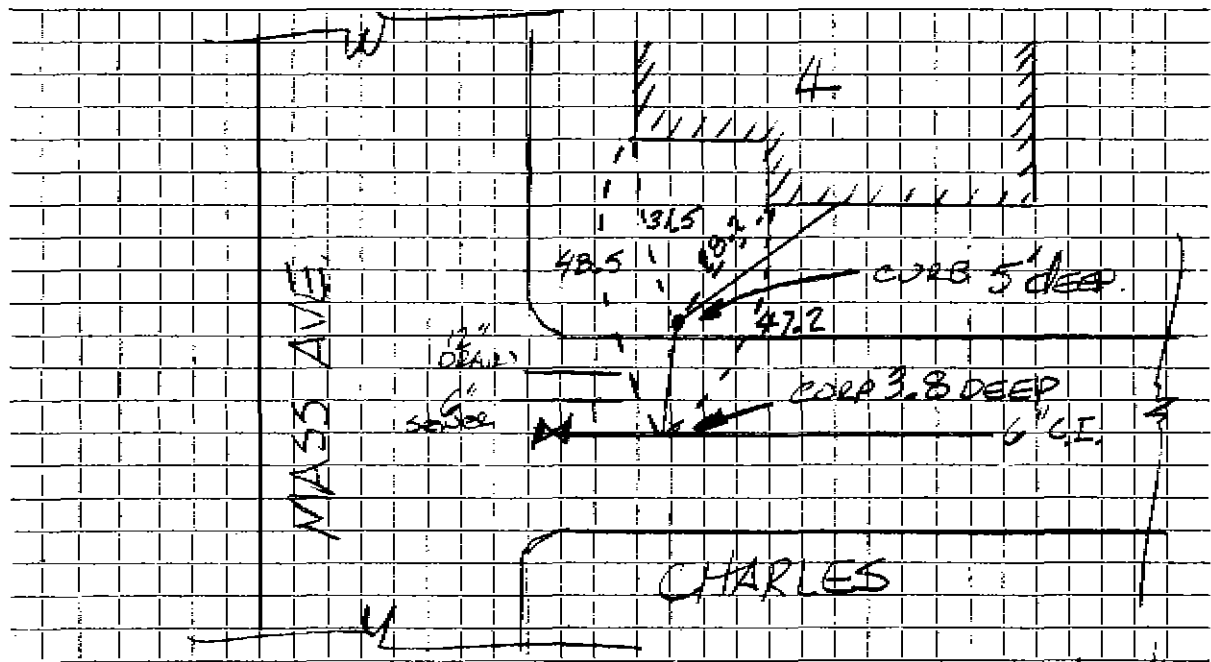

Connection made in 4 CHARLES AVE Street. Work completed 10/12/95

Remarks: J. Mc LAUGHLIN - CONTRACTOR  
J.F.H. - INSPECTOR