


TOWN OF LEXINGTON — BOARD OF PUBLIC WORKS

WATER DIVISION

Sketch of Service Here

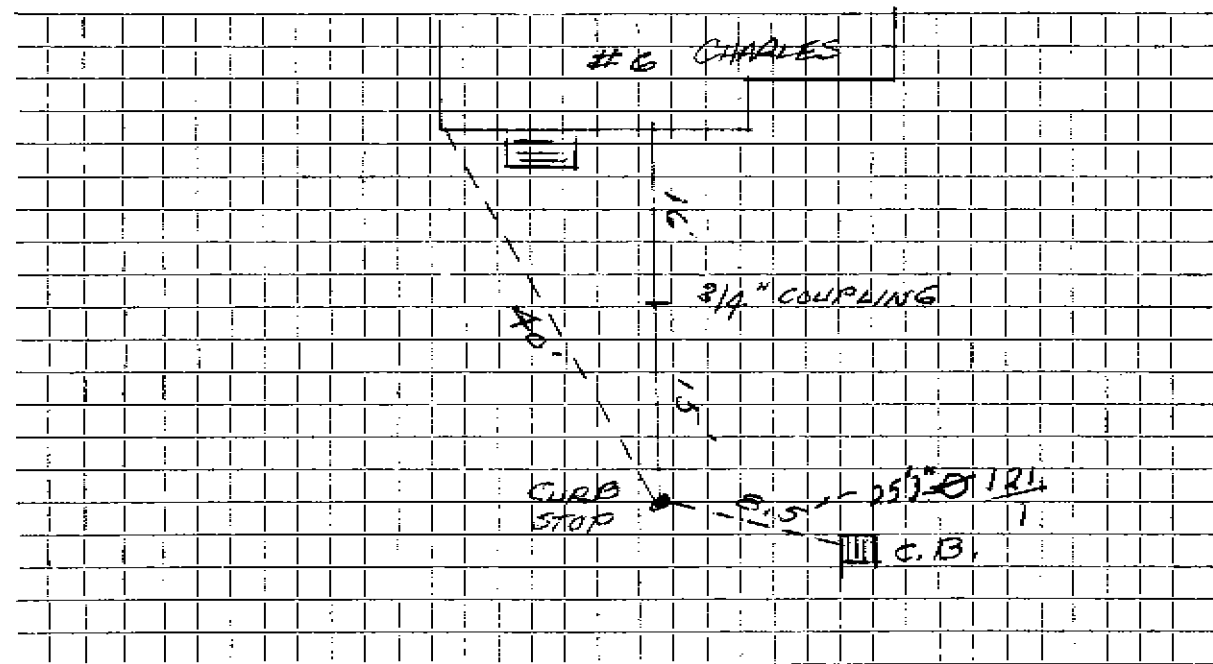

Connection made in Street. Work completed

Remarks: *CONNECT TO EXISTING CURB STOP*

2' outside curb IS A 2ND CURB unless Remove when Reversed