

Name

Service No. 527

Address 7 Charles St.

Location 7 Charles St. 2438

Kind of Pipe

Size

Size of Main

Repair—Renewal—New Service

Location

Date	Material	Amount	Total	Date	Amount
	Labor				

Hadley Press, Inc., Lexington

DATE _____

TOWN OF LEXINGTON—BOARD OF PUBLIC WORKS

WATER DIVISION

The undersigned applies for a supply of water at No. _____ St. and hereby agrees to comply with the rules and regulations as now, or at any future time, established by the Board of Selectmen.

Am't. of Estimate \$ _____


Owner M. A. Medeiros

Am't. Paid \$ _____

Address 7 # Charles St.

Builder _____

Sketch of Service Here

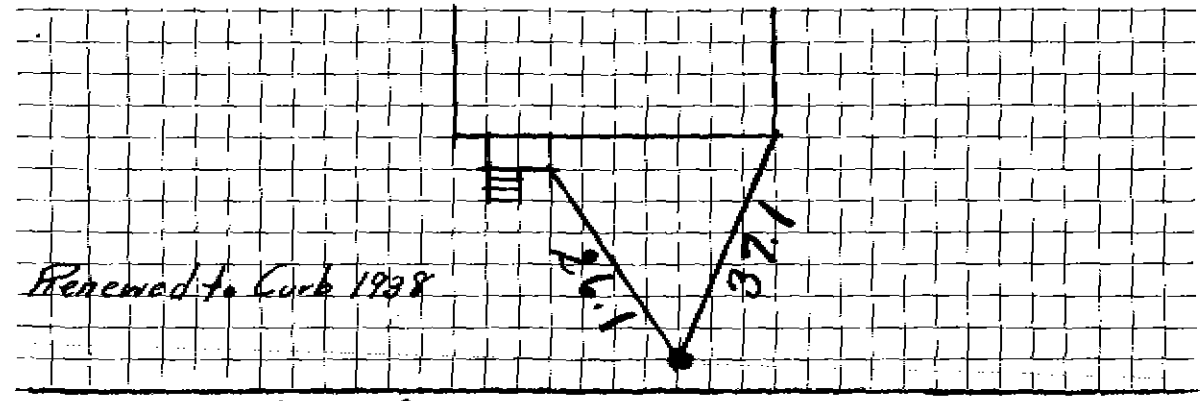

Connection made in Charles Street. St. Work completed _____ 19

Remarks: