

WATER SERVICE RECORD

Name **John Kiley**

Service No. **367 (1950)**

Address **10 Chase Avenue**

#2826

Location **Lexington 73, Mass.**

~~Repair~~ ~~General~~ **New Service**

Com. **2-19-51**


Date	Material	Amount	Total	Date		Amount
1-10-51	Labor	2 60	2 60	2-19-51	Deposited	20 00
	10% Overhead		26			
	32' - 3/4" Copper Tubing @ .34		10 88		No Charge	
	1 - 3/4" C x 1/2" I.W.H. S&W		4 00	1-10-51	Labor	2 60
	1 - 3/4" C x 3/4" C Union (3pts)		1 72	27' - 3/4" Copper Tubing @ .34		9 18
	Trucking 1 hr. @ .75		75	1 - 3/4" C Corp-cock		4 33
			20 21	1 - 3/4" C x 3/4" C Curb-cock		4 67
				1 - Box & Rod		3 90
				1 - 1/2" Offset Tail Piece		50
				1 - 1/8" Straight Tail Piece		50
				Trucking 1 hr. @ .75		75
						<u>26 43</u>

TOWN OF LEXINGTON — BOARD OF PUBLIC WORKS

WATER DIVISION

DATE _____

Sketch of Service Here

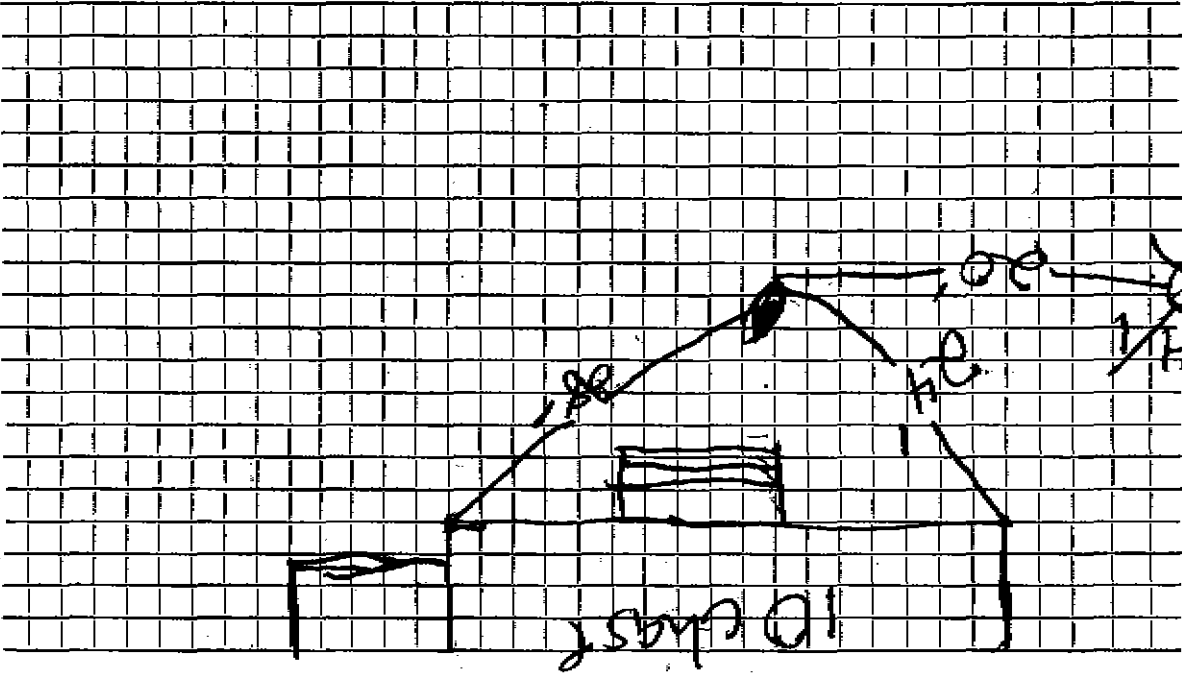

Work completed

Street

Connection made in

Remarks: