


DATE 11/1/18

TOWN OF LEXINGTON — BOARD OF PUBLIC WORKS
WATER DIVISION

Sketch of Service Here

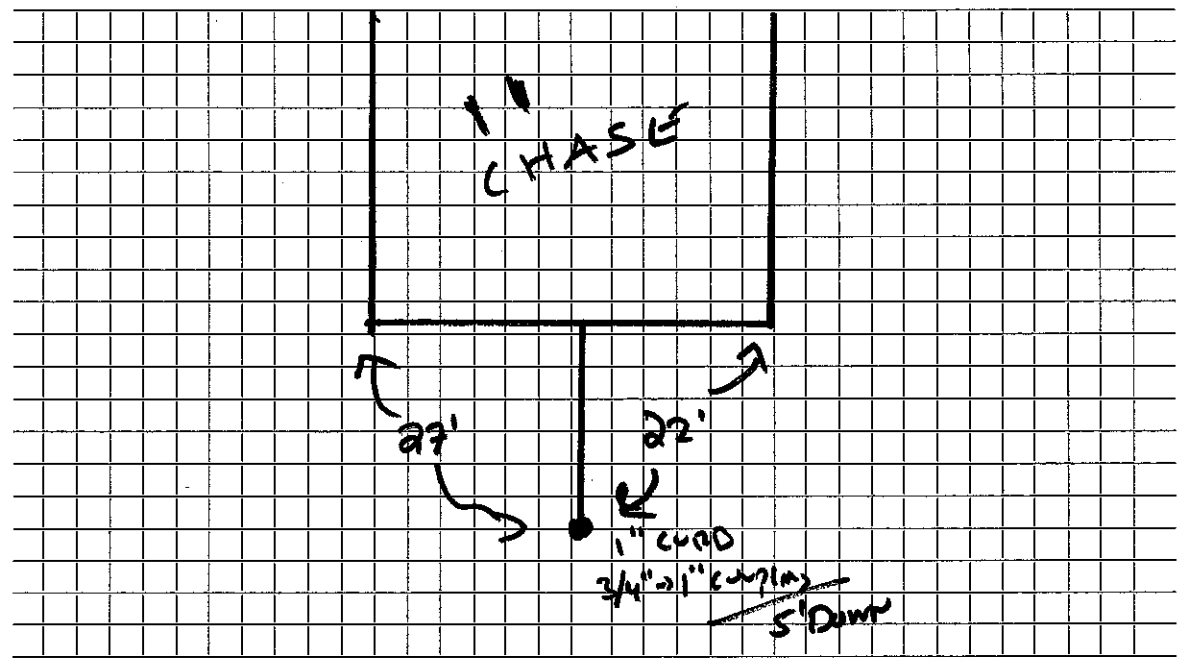

Connection made in CHASE Street. Work completed FERRANTE CONSTRUCTION

Remarks:

.....

.....