

WATER SERVICE RECORD

Name Richard Hamilton

Service No. 145

Address 12 Chase Ave

3173

Location

~~Repair~~ ~~Renewal~~ — New Service

Comm 8-22-66


Date	Material	Amount	Total	Date	Amount
7-25-60	Labor	2 05		7-21-66	50 00
	10% O.H.	21	2 26	8-22-66	23 09
44'	3/4" Copper tubing @42		18 48		26 91
1	3/4" Cx $\frac{1}{2}$ I.W.H. Stop&Waste		6 17		
			26 91		
					NON CHARGE
					Labor
				20' 3/4" Copper tubing @42	1 75
				1 3/4" C Curb Cock	8 40
				1 3/4" C Corp Cock	6 28
				1 Box & Rod	4 91
				1 $\frac{1}{2}$ Straight tailpiece	4 90
				1 $\frac{1}{2}$ Offset tailpiece	50
					50
					27 24

DATE _____

TOWN OF LEXINGTON — BOARD OF PUBLIC WORKS

WATER DIVISION

Sketch of Service Here

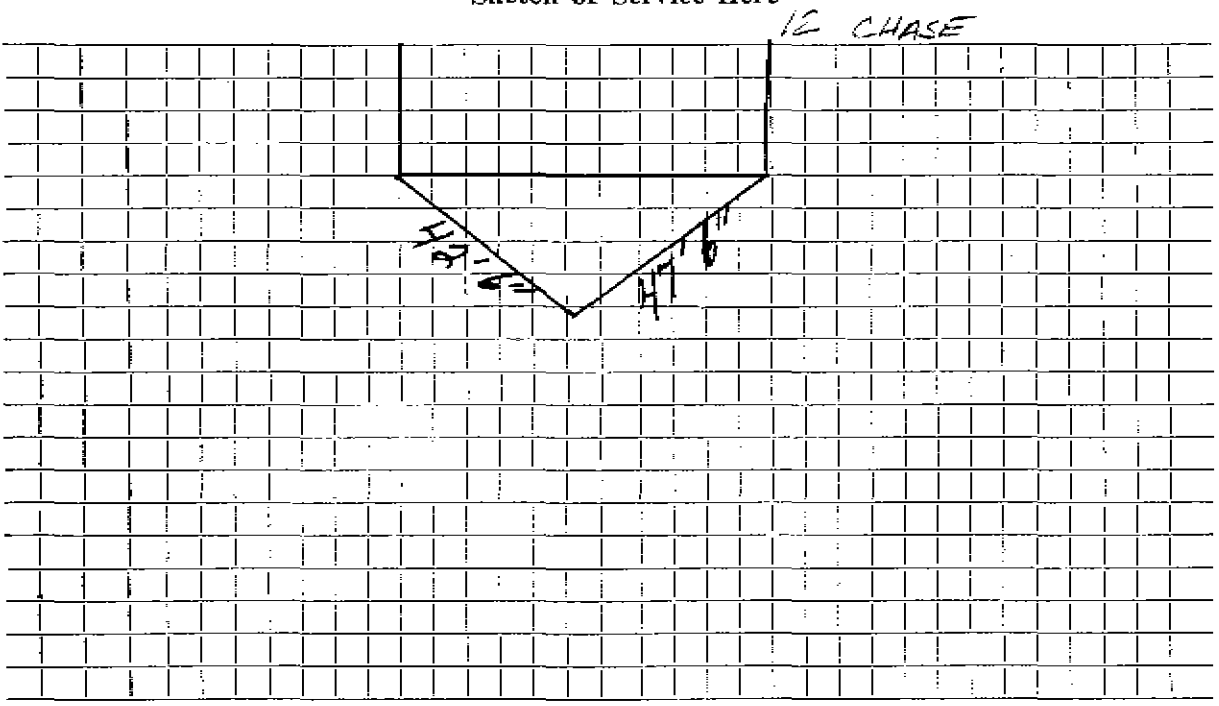

Connection made in Street. Work completed

Remarks:
.....
.....