


TOWN OF LEXINGTON — BOARD OF PUBLIC WORKS
WATER DIVISION

DATE 4/1/2021

Sketch of Service Here

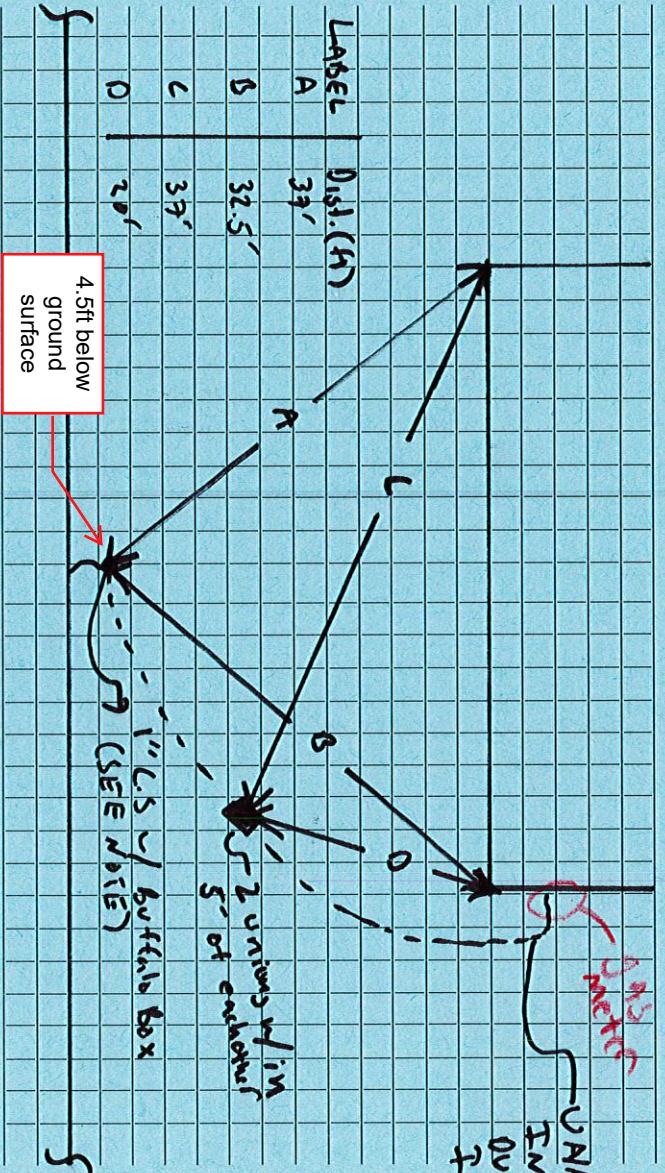

Connection made in..... Street.

Work completed.....

Remarks:.....

NOTE: 3/4" → 1" union to 1" curb stop.

Existing 3/4" C.S. removed b/c rotten

1 steel.

WATER SERVICE RECORD

Service No. W-20-82

Name IOVINO EXCAVATION

Address 14 Chase Ave

Location

Repair ~~Renewal~~ New Service

Date	Material	Amount	Total	Date	Amount
4/1/2021	ROAD → HOUSE				
	1" U.S. LAMB BARS OPEN RISE	①			
	Buffalo Box	①			
	1" TYPE K COPPER ~52'				
	1" BRASS UNION	②			

Name

Address

14 Chase Ave.

Service No. 545

72404

Location

14 Chase Ave.

Kind of Pipe

Size

Size of Main

Repair—Renewal—New Service

Location

Date

Material

Amount

Total

Date

Amount

Labor

DATE _____

TOWN OF LEXINGTON—BOARD OF PUBLIC WORKS

WATER DIVISION

The undersigned applies for a supply of water at No. _____ St. and hereby agrees to comply with the rules and regulations as now, or at any future time, established by the Board of Selectmen.

Am't. of Estimate \$ _____

Owner


J. Collins
14 ~~22~~ Chase ave.

Am't. Paid \$ _____

Address

Builder _____

Sketch of Service Here

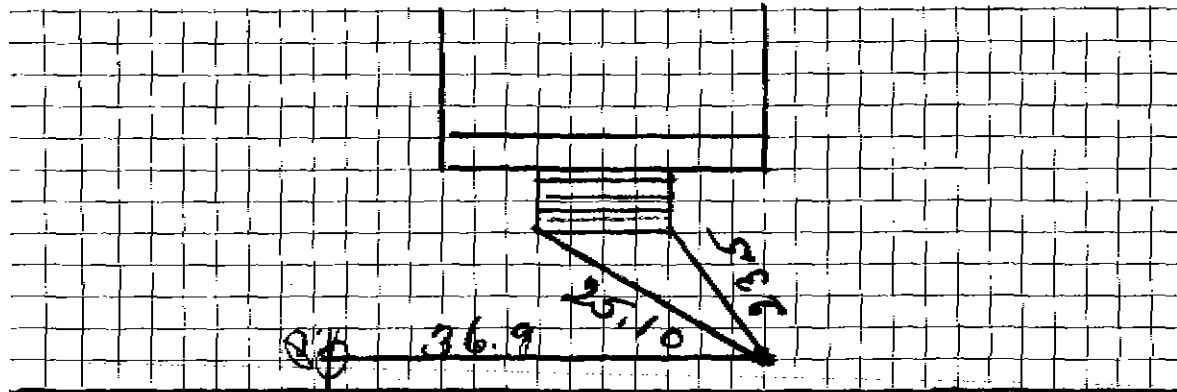

Connection made in Chase Street. ave Work completed _____ 19

Remarks: