

**WATER SERVICE RECORD**

Name John Butler

Service No. 35

Address 15-17 Chase Avenue

Location

~~REPAIR~~—Renewal—~~NEW SERVICE~~ W.O. #6687

NOV 13 1978

Date	Material	Amount	Total	Date	Amount	
10-5-78	Labor	25.00		10-2-78	Deposit	150.00
	10% O.H.	2.50	27.50		Refund	80.15
25'	3/4" Copper tubing @.74		18.50			69.85
1	3/4" Stop & Waste		17.10		OUTSIDE W.O. #6691	
2	1/2" Tail pieces @1.00		2.00	10-5-78	Labor	
1/2	hr. Trucking		1.50	9'	3/4" Copper tubing	
1/2	hr. Backhoe		3.25	1	3/4" Corp Adapter	
			69.85	1	3/4" Curb Stop	
				1	ton Cold Patch	
				1 1/2	hrs. Trucking	
				1 1/2	hrs. Town Shovel	


DATE \_\_\_\_\_

TOWN OF LEXINGTON — BOARD OF PUBLIC WORKS

**WATER DIVISION**

Sketch of Service Here

15-17 CHASE

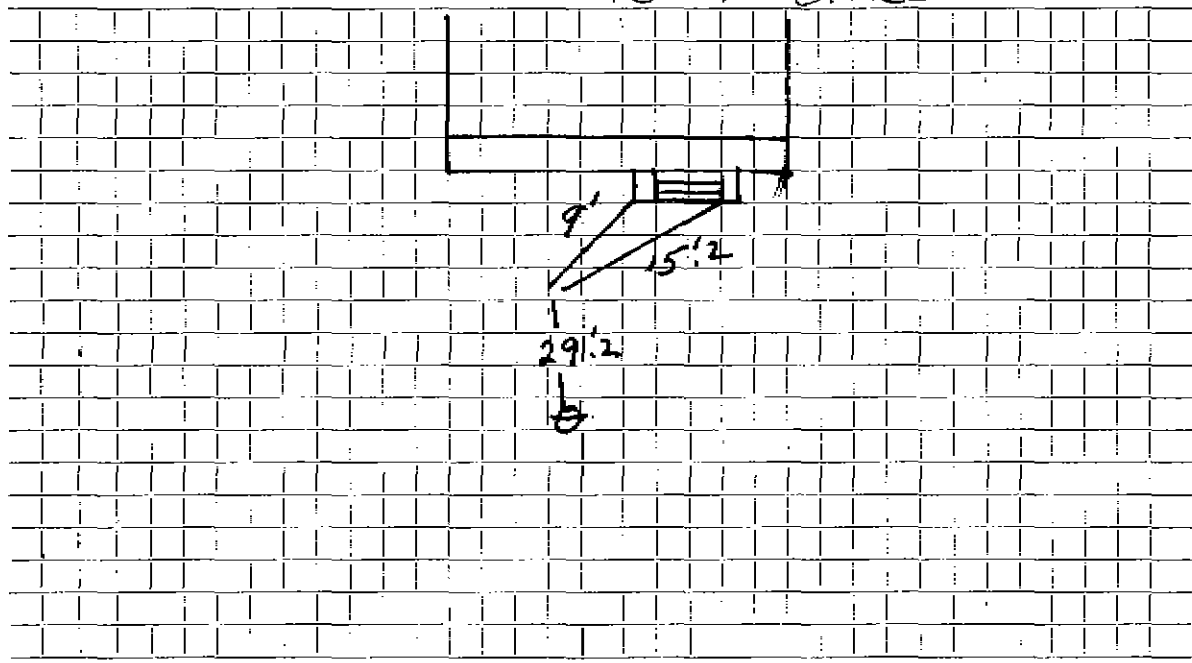

Connection made in ..... Street. Work completed .....

Remarks: .....  
.....  
.....