

5942

WATER SERVICE RECORD

Name Wesley Nelson

Service No. 113

Address 19 Chase Avenue

Location

~~Reading General~~ New Service W.O. #8241

Conn 27064


Date	Material	Amount	Total	Date		Amount
10-24-63	Labor	2.31		10-24-63	Deposit	100.00
	10% O.H.	.23	2.54	2-10-74	Refund	67.77
	56' 3/4" Copper tubing @.42		23.52			32.23
	1 3/4" C x 1/2 I.W.H. Stop & Waste		6.17		NON CHARGE	
			32.23	10-24-63	Labor	2.31
					12' 3/4" Copper tubing @.42	5.04
					1 3/4" C Corp Cock	4.91
					1 3/4" C Gurb Cock	6.28
					1 Box & Rod	4.90
					1 1/2 Straight tailpiece	.50
					1 1/2 Offset tailpiece	.50
						24.41

DATE _____

TOWN OF LEXINGTON — BOARD OF PUBLIC WORKS

WATER DIVISION

Sketch of Service Here

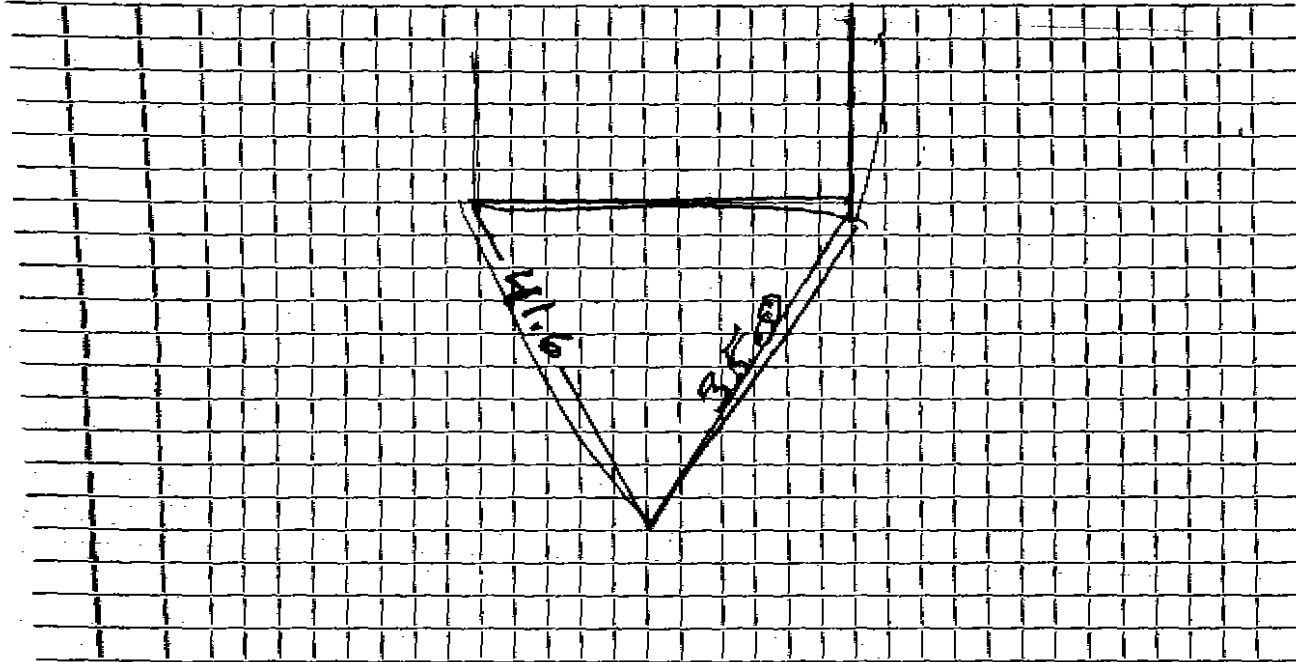

Connection made in Street. Work completed

Remarks:
.....
.....