

## WATER SERVICE RECORD

Name John Haskell

Service No. 13

Address 25 Chase Avenue

Location

Repair—Renewal—~~New Service~~ W.O. # ~~3~~ 6188

MAY 27 1969


Date	Material	Amount	Total	Date	Amount
4/30/69	Labor	30 30		4-24-69	300 00
	10% O.H.	3 03	33 33	5-27-69	232 27
	20' -3/4" Copper pipe .79		15 80		OUTSIDE 67 93
	1- 3/4" Wheel Valve		9 30	4/30/69	Labor 36 51
	1 Hr. trucking		3 00	5/6/69	" 6 49
	1 " shovel		6 50		16' -3/4" Copper pipe .79 12 84
			67 93		1- 3/4" Adaptor 2 76
					1- 3/4" Curb cock 11 32
					1 Box & Rod 5 10
					1/2 Yd Loam 3.50 1 75
					1/2 lb. Grass seed 1.10 55
					1/2 Ton hot top 5.80 1 45
					2 Hrs. trucking 3.00 6 00
					1/2 " " 1.50 75
					2 " shovel 6.50 13 00
					1/2 " compressor 5.00 2 50
					1/2 " roller 3.00 1 50
					tractor 2 00
					104 32

TOWN OF LEXINGTON -- BOARD OF PUBLIC WORKS

WATER DIVISION

DATE \_\_\_\_\_

Sketch of Service Here

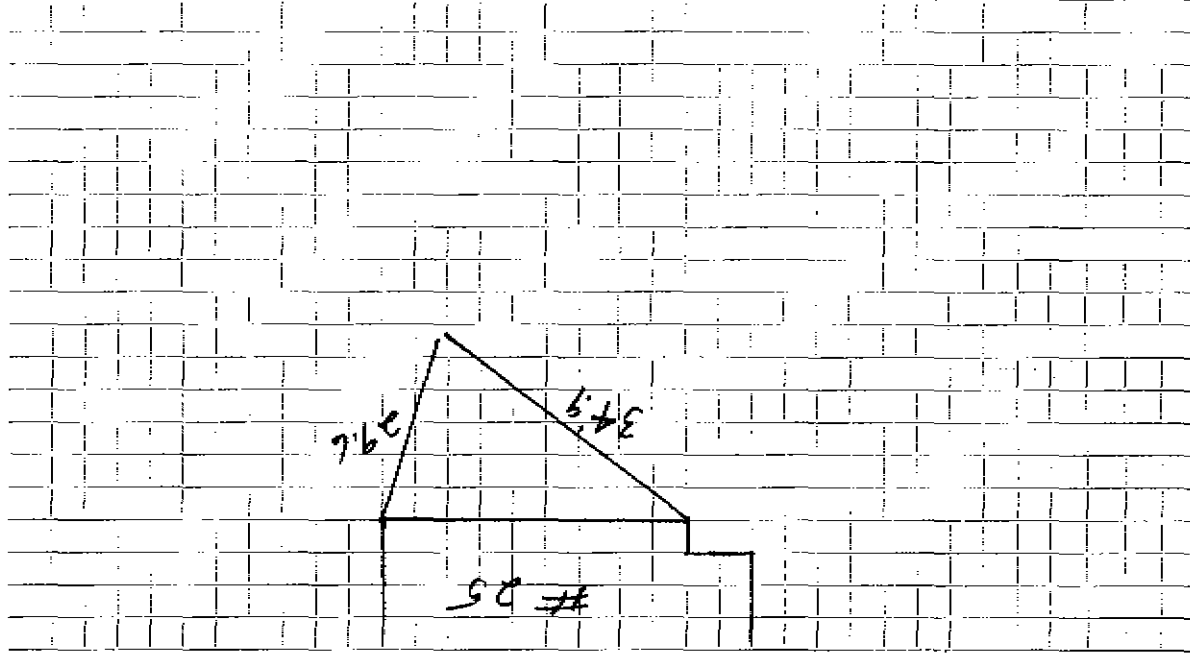

Work completed

Street

Connection made in

Remarks: