

WATER SERVICE RECORD

Name George Pekins

Service No. 61

Address 28 Chase Ave.

Location _____

~~Repair~~—Renewal—~~Work Order~~ W.O. 5082

DEC 12 1977


Date	Material	Amount	Total	Date	Amount
11/10/76	Labor	42 46		11-12-76	300 80
	10% O.H.	4 24	46 70	12-12-77	102 43
	32' 3/4 Copper @ .65		20 80		99 57
	2 1/2" Tail Pieces @ 1.30		2 60		
	2 1/2 x 3/4 Bushings @ 1.72		3 44		
	1 3/4 Wheelhandle		14 53		
	1 Hr. Town Shovel		6 50		
	1 Hr. Trucking		3 00		
			<u>97.57</u>		

DATE _____

TOWN OF LEXINGTON — BOARD OF PUBLIC WORKS
WATER DIVISION

Sketch of Service Here

28 CHASE

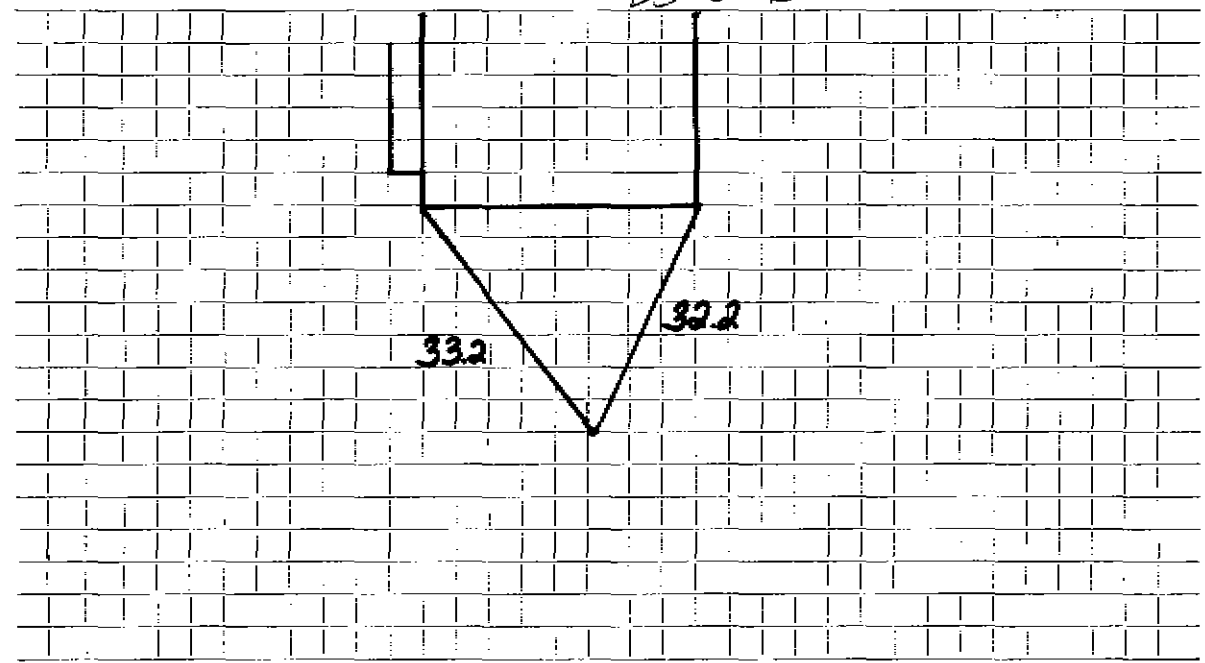

Connection made in Street. Work completed

Remarks:
.....
.....