

WATER SERVICE RECORD

Name C. G. Fitzgerald

Service No. 3

Address 29 Chase Ave.

Location Lexington

Repair—Renewal—New Service COM. 3-2-53


Date	Material	Amount	Total	Date	Amount
1/29/53	Labor	7 84		1-2-53	40 00
	10% overhead	78	8 62	3-2-53	23
	35'-3/4" Copper Tubing @.34		11 90		NON CHARGE
	1-3/4" C x 1/2 I.W.H. stop & waste		4 00	1/20/53	Labor
	2 Hrs. Littlefield Shovel @7.00		14 00		12'-3/4" Copper Tubing @.34
	1 Hr. Trucking		75		1-3/4" C. Adapter
			39 27		1-3/4" C. Gurb-cock
					1-Box & Rod
					2 Hrs. Littlefield Shovel @7.00
					2-3/8 offset tail piece @.50
					1 Hr. Trucking
					75
					46 35

DATE _____

TOWN OF LEXINGTON — BOARD OF PUBLIC WORKS

WATER DIVISION

Sketch of Service Here

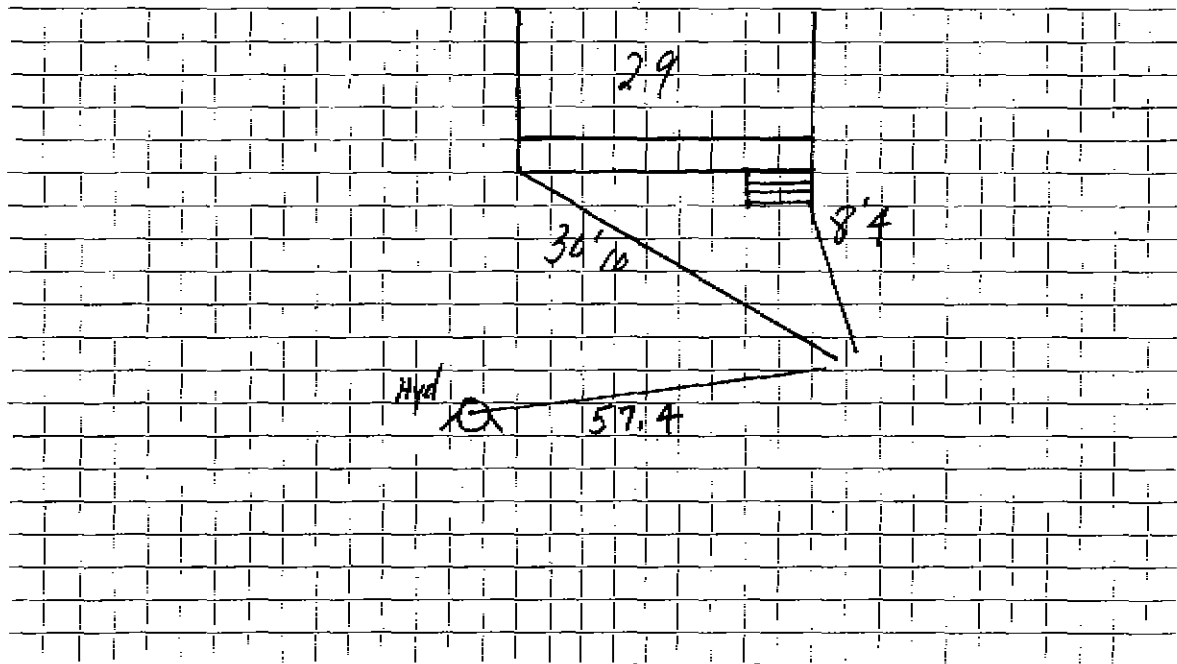

Connection made in Street. Work completed

Remarks:

.....
.....