

WATER SERVICE RECORD

Name Alfred Ragnelli

Service No. 30

Address 3 Chase Avenue

Location

~~Repair~~ - Renewal - ~~New Service~~ W.O. #6597

NOV 13 1978


Date	Material	Amount	Total	Date	Amount	
9-21-78	Labor	75.00		9-2-78	Deposit	100.00
	10% O.H.	7.50	82.50		* Paid by SHC# 56	29.59
29'	10" 3/4" Copper tubing @.616		17.93			129.59
1	3/4" Stop & Waste		17.10		OUTSIDE W.O. 6597	
1	3/4" x 1/2 Reducer		1.56	9-21-78	Labor	
1	1/2 Tailpiece		1.00	13'	6" 3/4" Copper tubing	
1/2	hr. Trucking		3.00	1	3/4" Corp	
1	hr. Backhoe		6.50	1	3/4" Gurb	
			129.59	3	hrs. Trucking	
				2	hrs. Backhoe	

DATE _____

TOWN OF LEXINGTON — BOARD OF PUBLIC WORKS

WATER DIVISION

Sketch of Service Here

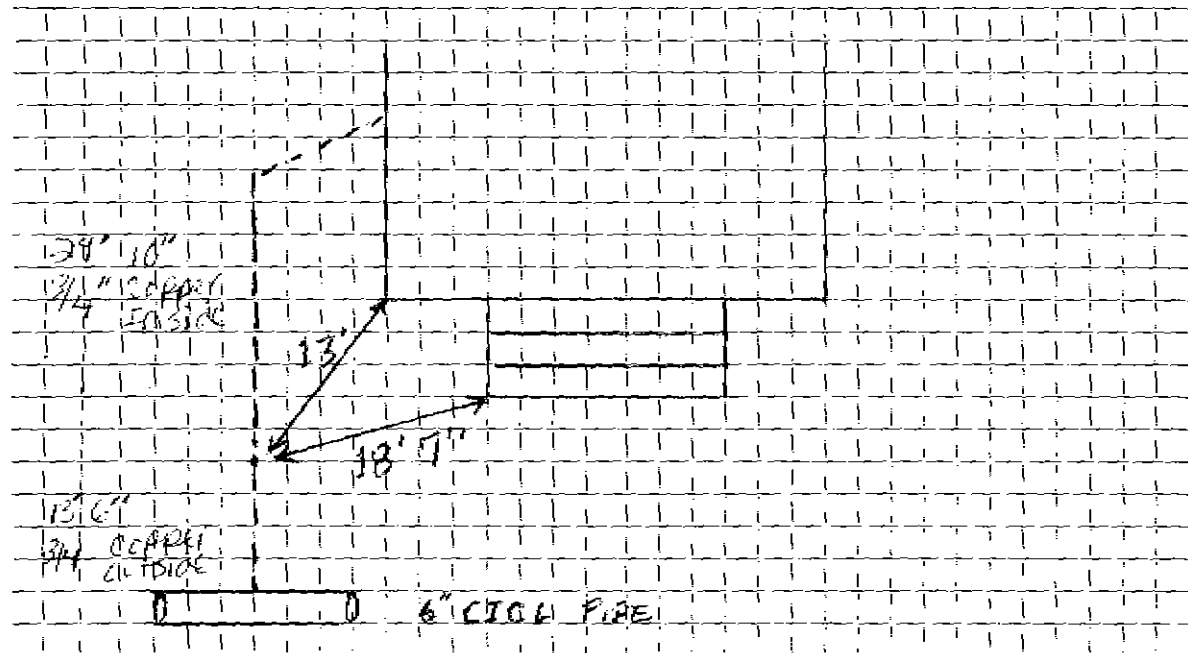

Connection made in #3 CHASE AVE Street. Work completed

Remarks: 29' 10" 3/4" COPPER INSIDE 13' 6" 3/4" COPPER OUTSIDE