

WATER SERVICE RECORD

Name Alice J. Heaney

Service No. 37

Address 31 Chase Ave.

Location

~~Repair~~ - Renewal - ~~New Service~~ W.O. 5828

DEC 12 1977


Date	Material	Amount	Total	Date	Amount
10/24/77	Labor	71 85		10/19/77	Deposit 200 00
	10% O.H.	7 18	79 03	12-12-77	Retard 22 35
	28' 3/4 Copper @ .83		23 24		127 75
	1 3/4 Wheelhandle		15 98	10/24/77	OUTSIDE
	1 Hr. Trucking		3 00	9'	3/4 COPPER
	1 Hr. Shovel		6 50	1	3/4 CURB
			127 75	1	3/4 CORP ADPTER
					130x + Rod

DATE _____

TOWN OF LEXINGTON — BOARD OF PUBLIC WORKS

WATER DIVISION

Sketch of Service Here

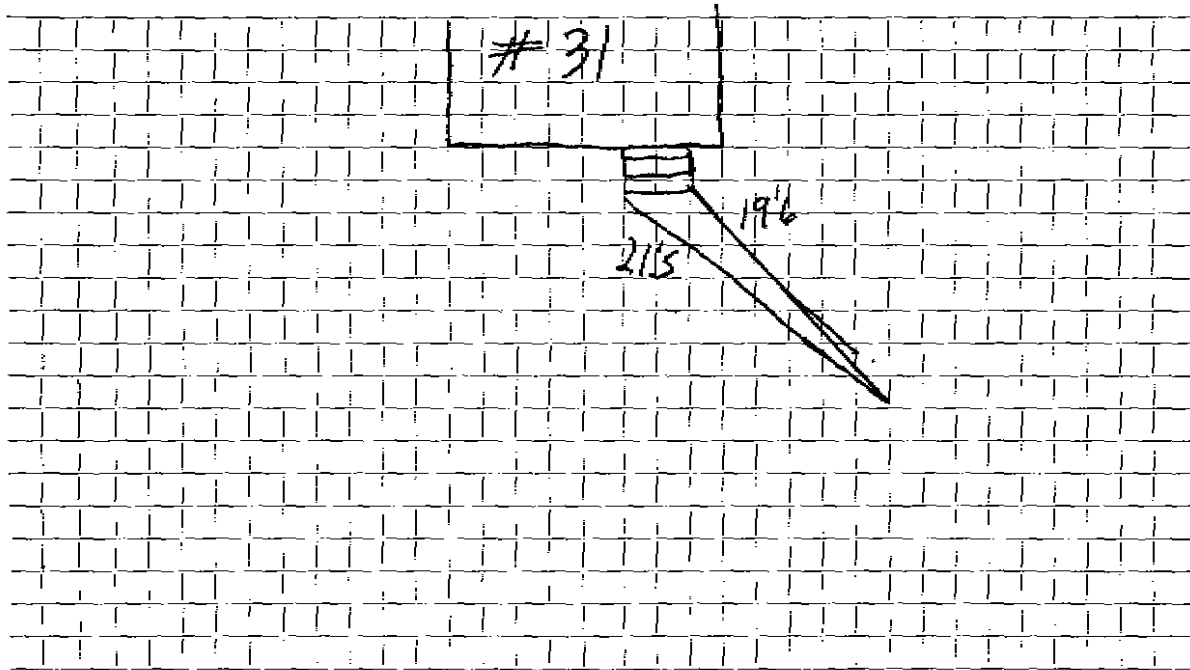

Connection made in Street. Work completed

Remarks:
.....
.....