

WATER SERVICE RECORD

Name Casemir Groblewski

Service No. 56

Address 32 Chase Ave.

Location

~~Repair~~ - Renewal - ~~New Service~~ WO #4928


MAY 9 1977

Date	Material	Amount	Total	Date	Amount	
10/1/76	labor	42. 84		10-1-76	Deposit	350. 00
	10%OH	4. 28	47. 12	5-9-77	Refund	350. 55
32'	3/4" Copper @ .65		20. 80			91. 25
1	wheel handle		14. 53		OUTSIDE	
1	offset tail piece		1. 00	11/14/76	labor	128. 52
1/2	hr. pickup truck @ 3.00		1. 50		10%OH	12. 85
1	hr. shovel @ 6.50		6. 50		18' X 6' patch	78. 00
			91. 45		5' X 20' patch	66. 66
				23'	3/4" copper @ .65	14. 95
				1	3/4" curb cock	13. 70
				1	ton coal patch	12. 50
				1 1/2	truck @ 3.00	4. 50
				2	hr. shovel @ 6.50	13. 00
						344. 68

DATE _____

TOWN OF LEXINGTON — BOARD OF PUBLIC WORKS
WATER DIVISION

Sketch of Service Here

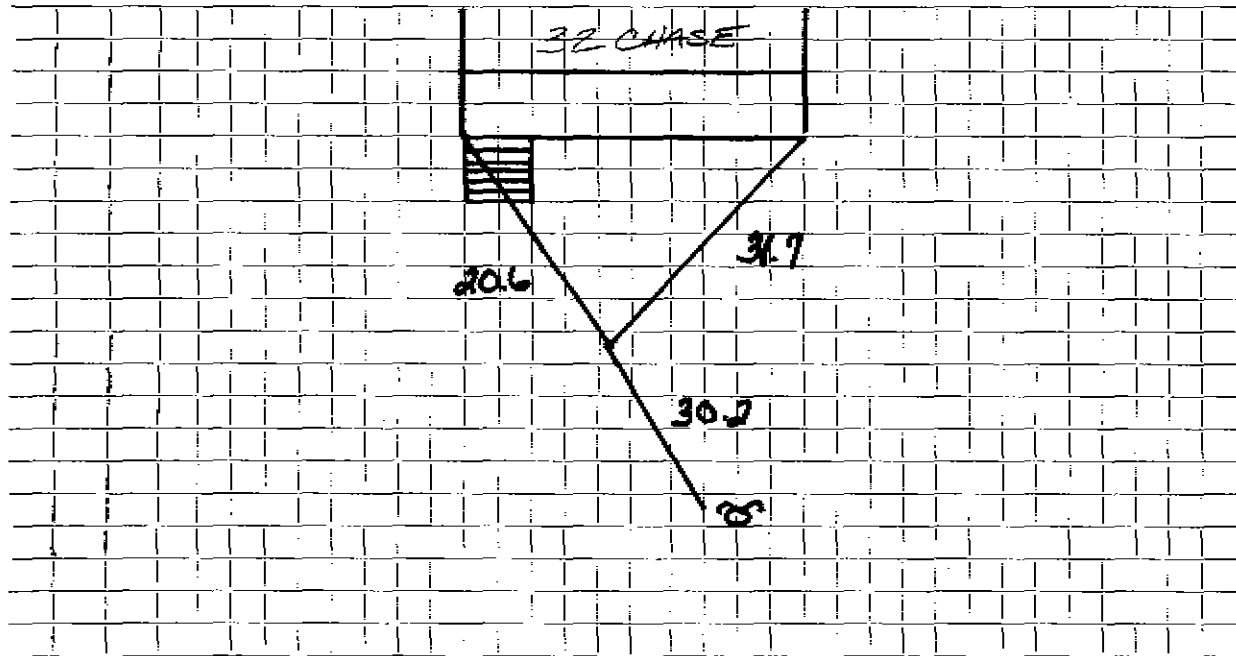

Connection made in Street. Work completed

Remarks:
.....
.....