

WATER SERVICE RECORD

Name Anthony Graziano

Service No. 26

Address 35 Chase Ave

Location

~~REPAIRS~~ - New Service


Comm 7-5-60

Date	Material	Amount	Total	Date	Amount
5-18-60	Labor	1 94		4-5-60	Deposit 50 00
	10% O.H.	20	2 14	7-5-60	<del>Retard</del> 16 49
60'	3/4" Cooper tubing @42		25 20		33 51
1	3/4" Cx 1/2 I.W.H. Stop&Waste		6 17		<u>NON CHARGE</u>
			33 51		Labor 1 88
				8'	3/4" Copper tubing @42 3 36
				1	3/4" C Corp Cock 4 91
				1	3/4" C Curb Cock 6 28
				1	Box & Rod 5 00
				1	1/2 Straight tailpiece 50
				1	3/8 Offset tailpiece 50
					<u>22 43</u>
					<del>Applied to 5102#29</del>

DATE \_\_\_\_\_

**TOWN OF LEXINGTON — BOARD OF PUBLIC WORKS**  
**WATER DIVISION**

Sketch of Service Here

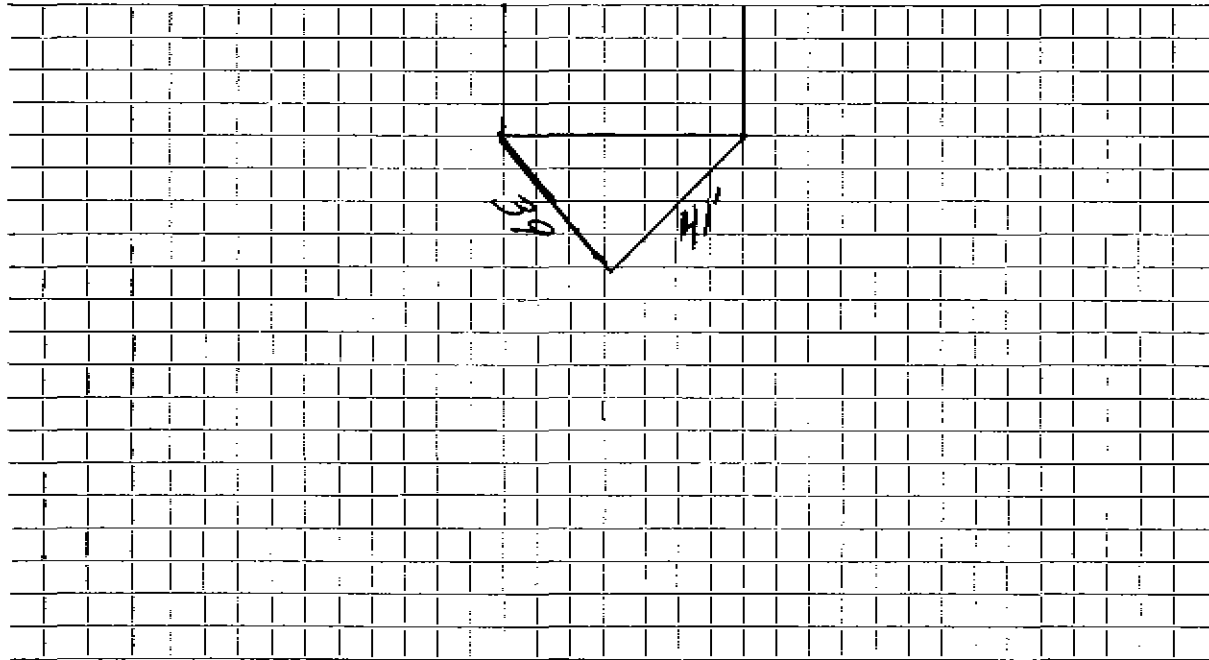

Connection made in ..... Street. Work completed .....

Remarks: .....

.....  
.....