

WATER SERVICE RECORD

376

Name Francis Campasi

Service No. 179

Address 36 Chase Avenue

Location Lexington, Mass.

Repair/Renewal - New Service


Com. 10/1/51

Date	Material	Amount	Total	Date		Amount
8-29-51	Labor	1 65	1 65	8-3-51	Deposited	15 00
	10% Overhead		17	10-4-51	Paid	1 20
	30'-3/4" Copper Tubing @.326	9 78	9 78			16 20
	1-3/4"Cx3/4" I.W.H. S&W	4 00	4 00		No Charge	
	1 Hr. Trucking		75	8-29-51	Labor	1 65
			16 35		30'-3/4" Copper Tubing @.326	9 78
					1-3/4"C. Corp Cock	4 33
					1-3/4"Cx3/4"C Curb-Cock	4 67
					1- Box & Rod	4 68
					1-1/2 Offset Tail Piece	50
					1-1/2 Straight Tail Piece	50
					1 Hr. Trucking	75
						26 86

DATE _____

**TOWN OF LEXINGTON — BOARD OF PUBLIC WORKS
WATER DIVISION**

Sketch of Service Here

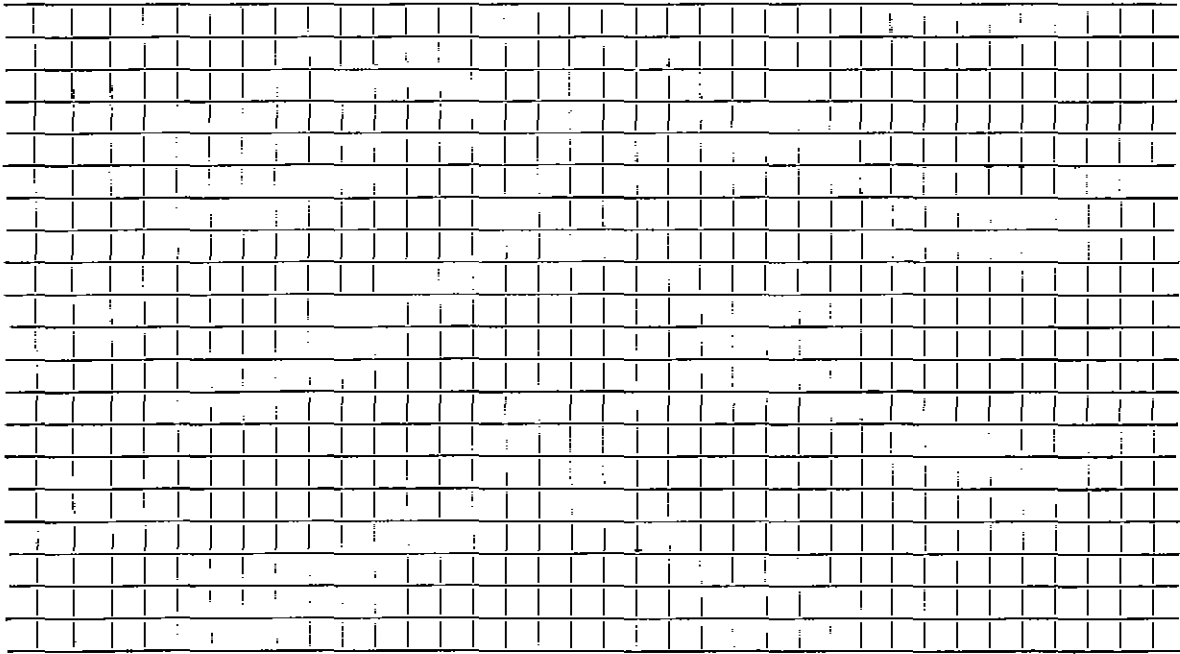

Connection made in Street. Work completed

Remarks:

.....

.....