




DATE 11/2018

TOWN OF LEXINGTON — BOARD OF PUBLIC WORKS

WATER DIVISION

Sketch of Service Here

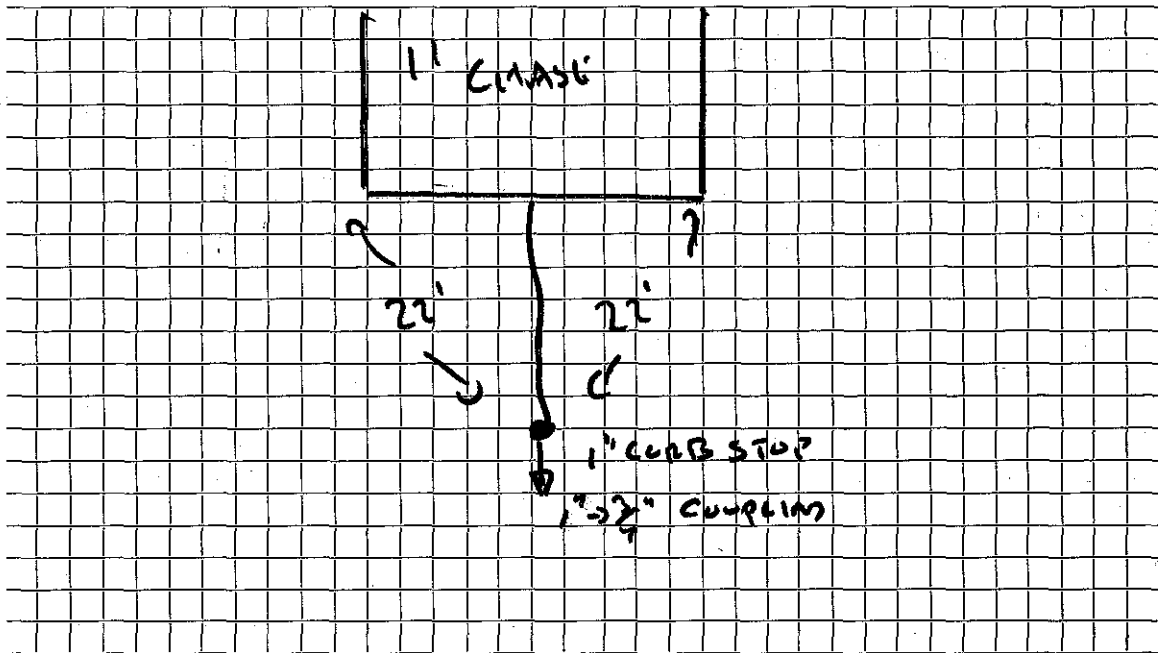

Connection made in CHASE Street. Work completed FERRANTE

Remarks: OLD CURB BURIED