

WATER SERVICE RECORD

Name Malcolm H. CliffordService No. 5Address 54 Chase Avenue

Location _____

~~REPAIR~~ - Renewal - ~~Water Service~~

Conn 3-6-61


Date	Material	Amount	Total	Date	Amount	
1-24-61	Labor	43.06		1-24-61	Deposit	75.00
	10% C.H.	4.31	47.37	3-6-61	Retard	3.89
	15' 3/4" Copper tubing @.42		6.30			71.11
1	3/4" C x 1/2" I.W.E. Stop & Waste		6.17		NON CHARGE	
1	3/4" x 3/4" Male 2 part union		1.33	1	Box & Rod	4.90
1	3/4" x 1" Brass Bushing		.94	1	1/2" Straight tailpiece	.50
1	hr. Trucking @3.00		3.00	1	1/2" Offset tailpiece	.50
2	hrs. Compressor @3.00		6.00			5.90
			71.11			
					16' 3/4" Copper tubing @.42	6.72
					1 3/4" C Adapter	1.62
					1 3/4" C Curb Cock	6.28
					1 hr. Town Shovel @ 5.50	5.50
					1 hr. Trucking @ 3.00	3.00
						38.76

DATE _____

TOWN OF LEXINGTON — BOARD OF PUBLIC WORKS

WATER DIVISION

Sketch of Service Here

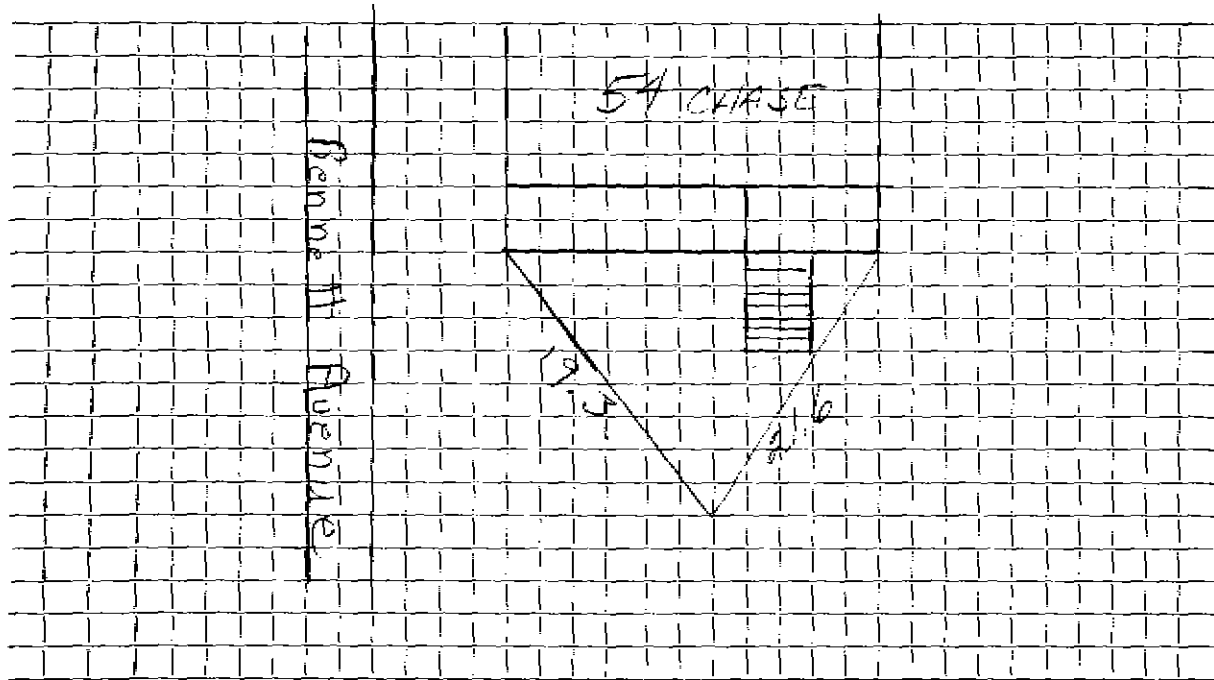

Connection made in Chase Avenue Street. Work completed

Remarks:

.....

.....