

8521

WATER SERVICE RECORD

Name John E. Keddy

Service No. 152

Address 59 Chase Avenue

Location

~~REPAIR~~ New Service WO #7704

Comm 1-14-63


Date	Material	Amount	Total	Date	Amount
11-7-62	Labor	2.13		11-1-62	Deposit 50.00
	10% O.H.	.21	2.34	1-14-67	Refund 25.11
39'	3/4" Copper tubing @.42		16.38		24.89
1	3/4" CX 1/2 I.W.H. Stop & Waste		6.17		
			24.89		
					NON CHARGE
				11-7-62	Labor 1.78
				9'	3/4" Copper tubing @.42 3.78
				1	3/4" C Corp Cock 4.91
				1	3/4" C Curb Cock 6.28
				1	Box & Rod 4.90
				1	1/2 Straight Tailpiece .50
				1	1/2 Offset Tailpiece .50
					22.65

DATE _____

TOWN OF LEXINGTON — BOARD OF PUBLIC WORKS

WATER DIVISION

Sketch of Service Here

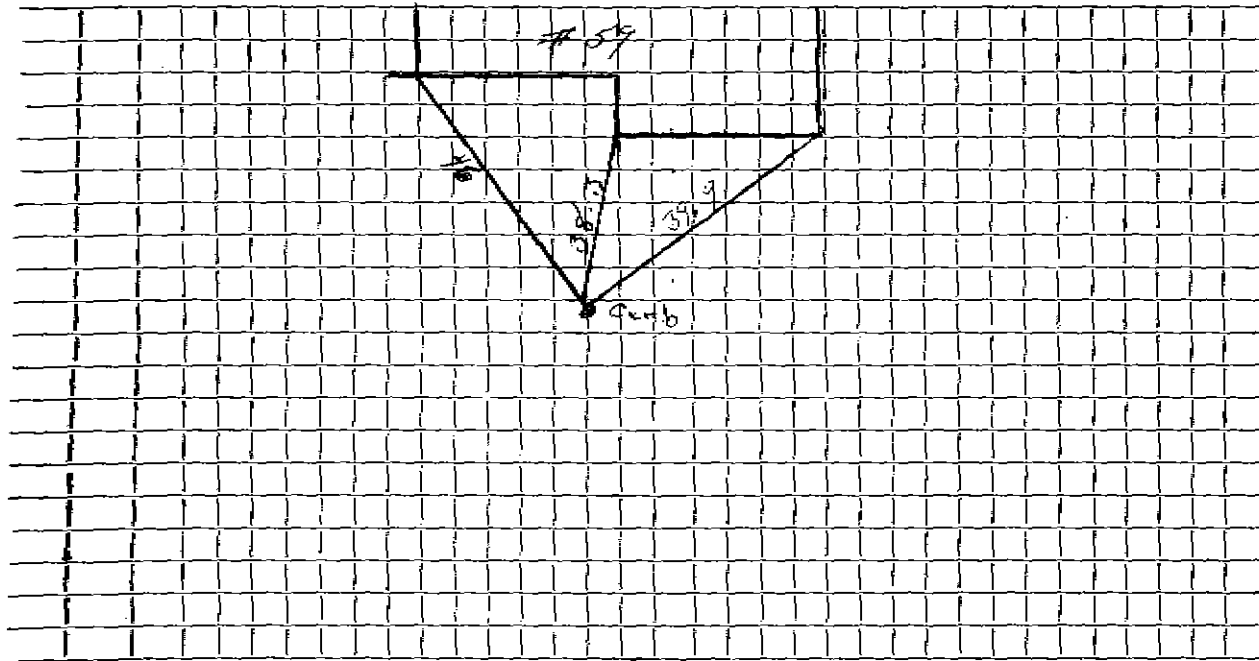

Connection made in Street. Work completed

Remarks:

.....

.....