

WATER SERVICE RECORD

5930
6073

Name

Service No.

Address 60 Chase Avenue

Location


~~Repair~~—Renewal—~~WATER SERVICE~~ W.O. #129

Date	Material	Amount	Total	Date	Amount
4-21-65	Labor	42 44			
	10% O.H.	4 24	46 68		
18'	3/4" copper tubing @.42		7 56		
1	3/4 Corp		7 41		
1	3/4 Curb		8 76		
1	Box & Rod		4 90		
1	1" x 5" nipple		65		
1	1" Lead lined coup.		60		
1	Hr. Town Shovel		6 50		
1	Hr. Town Truck		3 00		
1	Hr. Loader		4 00		
			90 06		

DATE _____

TOWN OF LEXINGTON — BOARD OF PUBLIC WORKS
WATER DIVISION

Sketch of Service Here

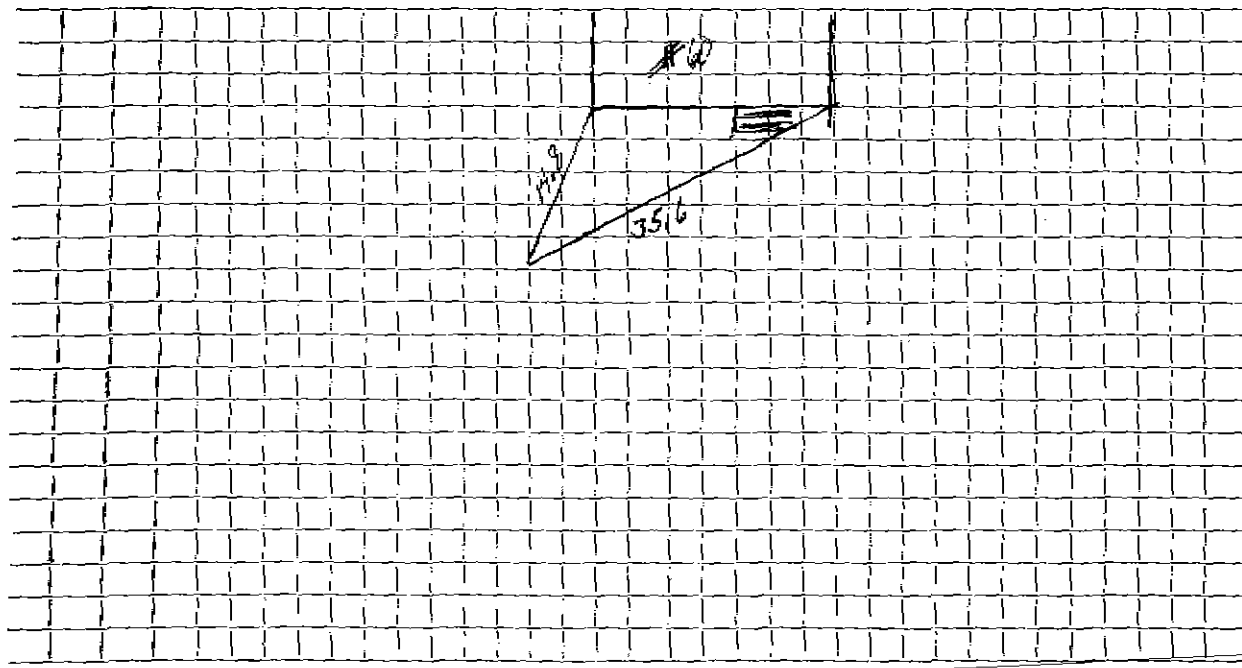

Connection made in Street. Work completed

Remarks:
.....
.....