

WATER SERVICE RECORD

Name

Service No.

Address 62 Chase Avenue

Location

~~Original - Renewal - Not Service~~ W.O. #949


Date	Material	Amount	Total	Date	Amount
9-14-65	Labor	46.76			
	10% O.H.	4.68	51.44		
22'	3/4" Copper tubing @42		9.24		
1	3/4" Adapter		2.76		
1	3/4" Curb		8.76		
1	1 x 1 1/4 Coupling		.86		
1	3/4" x 4 Nipple		.46		
1	hr Town Truck		3.00		
2	hrs. Tractor @6.50		13.00		
			89.52		

DATE _____

TOWN OF LEXINGTON — BOARD OF PUBLIC WORKS

WATER DIVISION

Sketch of Service Here

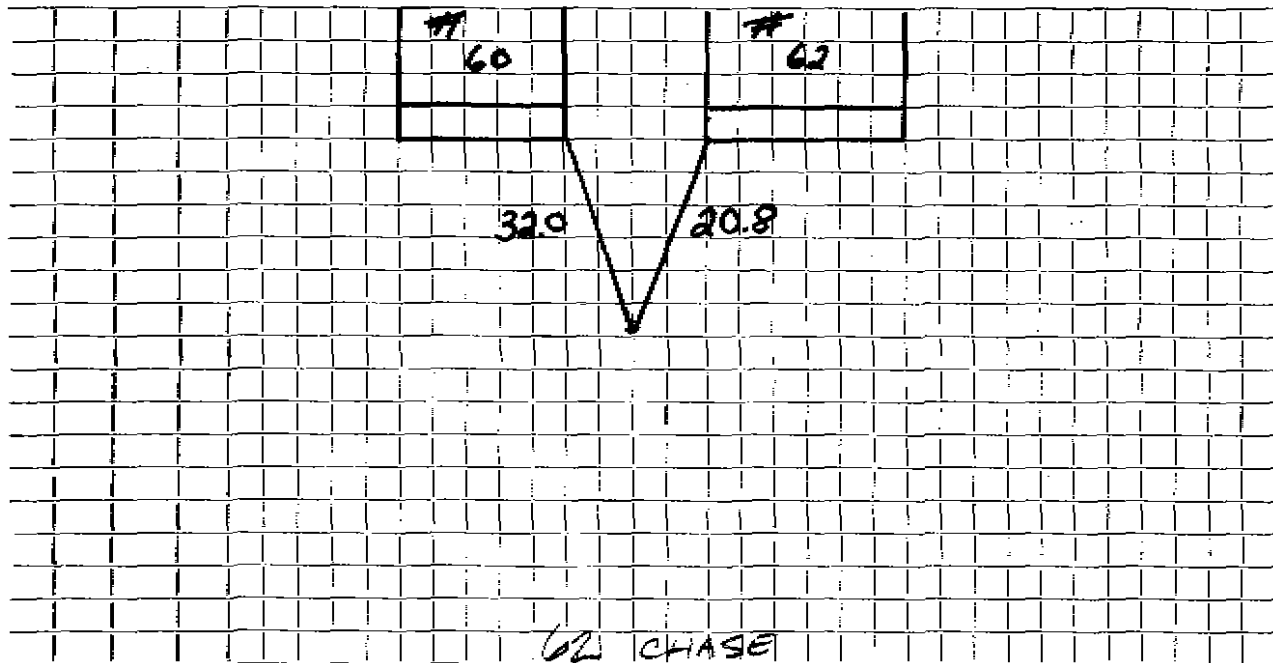

Connection made in _____ Street. Work completed _____

Remarks: _____

