

Name John Kiley

Service No. ~~352~~ 542

Address 8 Chase Avenue, Lexington

Location

Kind of Pipe

Size

Size of Main

Repair—Renewal—New Service

Location

Date	Material	Amount	Total	Date	Amount
1941					
Dec. 23, <i>Com' 7/24/41</i>	4 hrs. @ 60¢	2 40		<i>Dec. 18 1941</i>	<i>12 00</i>
	10% Overhead	<u>24</u>	2 64	<i>Dec 30 1941</i>	<i>1 54</i>
	24' 3/4" Copper tubing @ 19¢		4 56		<i>10 44</i>
	1 3/4" C.x 1/2" I.S. & W.		2 50		
	1 hr. trucking		<u>75</u>		
			10 45		
	Labor				

Hadley Press, Inc., Lexington

DATE _____

TOWN OF LEXINGTON—BOARD OF PUBLIC WORKS

WATER DIVISION

The undersigned applies for a supply of water at No. _____ St. and hereby agrees to comply with the rules and regulations as now, or at any future time, established by the Board of Selectmen.

Am't. of Estimate \$ _____

Owner _____


Am't. Paid \$ _____

Address _____

Builder _____

8 CHASE

Sketch of Service Here

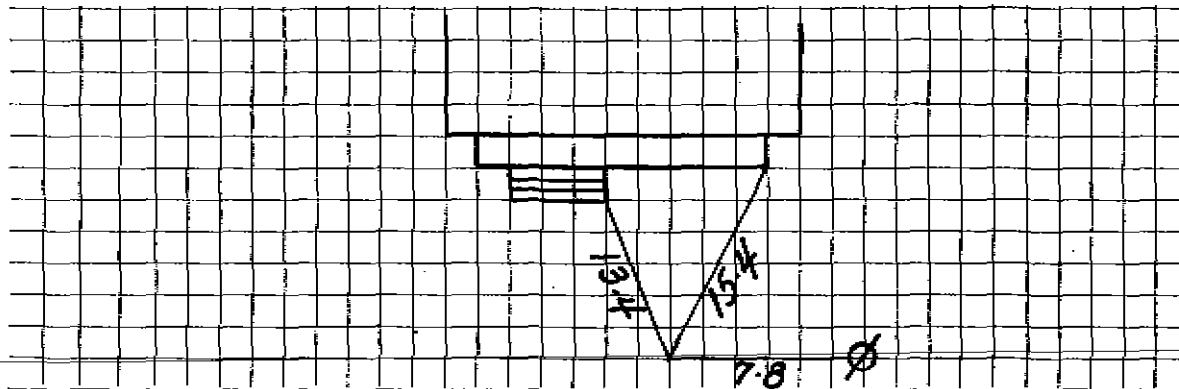

Connection made in _____ Street.

Work completed _____ 19

Remarks: