

Name George A. Barnes

Service No. 14

Address 9 Chase Avenue

Lexington, Mass.

Location 9 Chase Avenue

Kind of Pipe

Size

Size of Main

RENEWAL

~~RENEWAL~~

Com. 6-14-49

Location

Date	Material	Amount	Total	Date	Amount
Apr. 25, '49	Labor	5 75		Jan 31 '49	85 00
26	"	15 00	20 75	June 24 '49	1 65
	10% Overhead		2 08		22 85
	24' - 3/4" Copper Tubing @ .27		6 48		Non-Charge
	1 - 3/4" C x 1/2" I.W.H. S&W		3 29	Apr. 25, '49	Labor
	Trucking 1 hr. @ .75		75	10' - 3/4" Copper Tubing @ .27	2 70
			33 35	1 - 3/4" C Adapter	1 50
8-6-29	25' 1" C.L. pipe @ .27	6 75		1 - 3/4" C x 3/4" Curb-cock	3 85
	1 1" LL. pipe Cap	30		1 - 1/2" Offset Tail Piece	37
	1 1" LL. Ell.	35		1 - 1/2" Straight Tail Piece	37
	1 1" Br. Sp. Nip	25		Trucking 1 hr. @ .75	75
	1 StW	3 00		Patching 7 x 3	7 00
	TRUCKING	75			42 37
			11 40		
				Sept 5, 1929 Cash	11 40

DATE _____

TOWN OF LEXINGTON - BOARD OF PUBLIC WORKS

WATER DIVISION

The undersigned applies for a supply of water at No. St. and hereby agrees to comply with the rules and regulations as now, or at any future time, established by the Board of Selectmen.

Am't of Estimate \$.....

Owner


Am't Paid \$.....

Address

Builder

9 CHASE

Sketch of Service Here

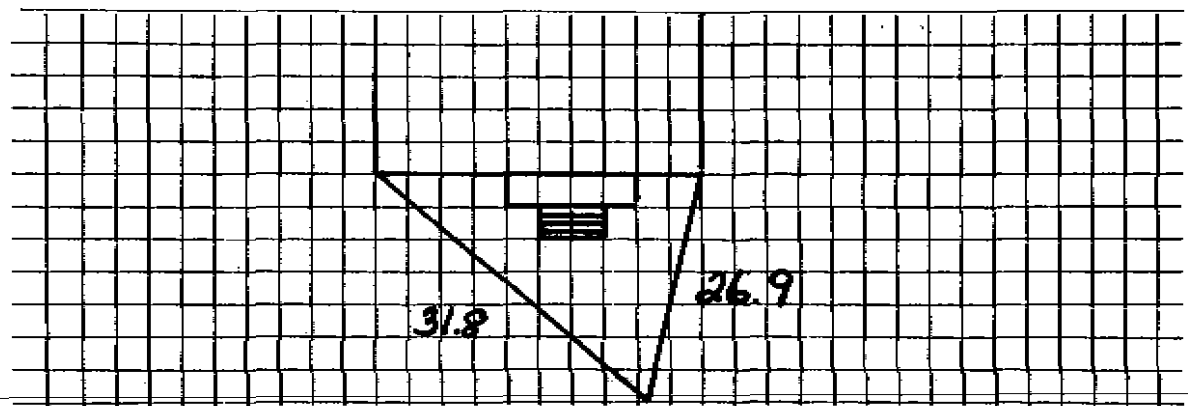

Connection made in Street.

Work completed19

Remarks: