

Name Ivar D. Johnson

Service No. # 556

Address ~~36 Parkham St., Arlington~~  
#1 ~~78~~ Cherry St.

3140

Locatio Lot # ~~28~~ #1 Cherry Street

Kind of Pipe

Size

Size of Main

~~Repairs~~ ~~Renewal~~ - New Service

Location

Date

Material

Amount

Total

Date

Amount

1935

June 3

*Com. to Russell  
6-8-35 #1575*

4 Hrs. @ 55¢

2 20

*May 10, 1935*

*Deposited*

*15.75*

4 " @ 60¢

2 40

4 60

32' 1" C.L. Pipe @ 20¢

6 40

2 1" L.L. Coup. @ 25¢

50

*6-17-05*

*Outside:  
Renewed*

1 1" L.L. Ells @ 30¢

30

*13'-1" Copper*

1 1" Brass Nipple @ 20¢

20

*1-1" Cop Adaptor*

1 S. & W.

2 75

*1-1" Curb Stop*

Trucking

1 00

11 15

15 75

Labor

~~18.00~~  
15.75

DATE May 10, 1935

TOWN OF LEXINGTON—BOARD OF PUBLIC WORKS  
WATER DIVISION

The undersigned applies for a supply of water at No. Lot #43 Cherry St St. and hereby agrees to comply with the rules and regulations as now, or at any future time, established by the Board of Selectmen.

Am't. of Estimate \$ 15.75


Owner Loar S. Johnson

Am't. Paid \$ \_\_\_\_\_

Address 36 Fordham St

Builder \_\_\_\_\_

Arlington

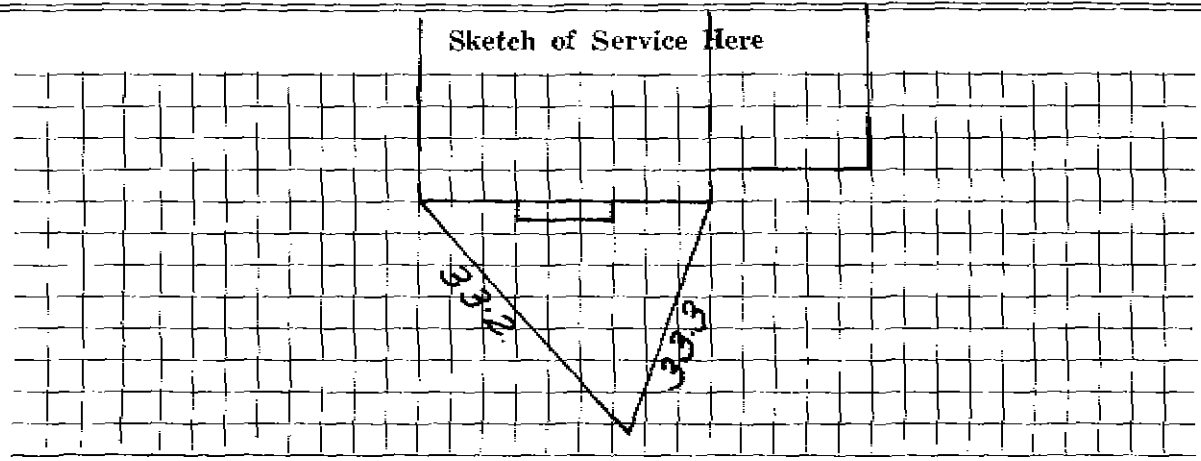

Connection made in \_\_\_\_\_ Street.

Work completed \_\_\_\_\_ 19

Remarks: