

WATER SERVICE RECORD

Name Louis Bonadio

Service No. 130

Address 11 Cherry Street

Location


~~Repair/ Renewal~~ New Service#3901
#7389
Comp 8-22-60

Date	Material	Amount	Total	Date	Amount
7-25-60	Labor	1 75		7-18-60	50 00
	10% O.E.	18	1 93	8-22-60	20 90
	50' 3/4" Copper tubing @ .42		21 00		29 10
	1 3/4" Cox I.W.R. Stop & Waste		6 17		
			29 10		
					NON CHARGE
				7-25-60	Labor 1 69
					40' 3/4" Copper tubing @ .42 16 80
					1 3/4" C Corp cock 4 91
					1 3/4" C Curd cock 6 28
					1 Box & Rod 4 90
					1 1/2" Straight tailpiece 50
					1 1/2" Offset tailpiece 50
					26 x 3 Patch 26 00
					61 58

DATE _____

TOWN OF LEXINGTON — BOARD OF PUBLIC WORKS
WATER DIVISION

Sketch of Service Here

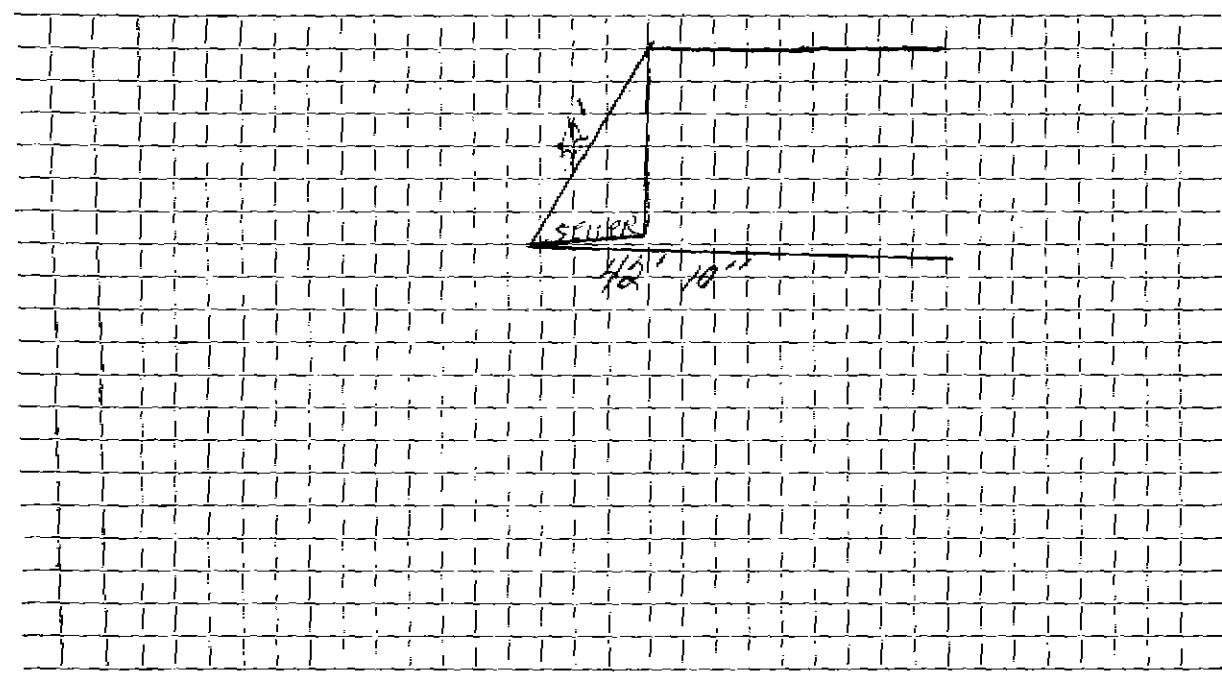

Connection made in Street. Work completed

Remarks:
.....
.....