

WATER SERVICE RECORD

Name

Service No.

Address 14 Cherry Street

Location


~~Repair~~—Renewal—~~New Service~~ W.O. #0631

Date	Material	Amount	Total	Date	Amount
11/18/30	30' 1" C.L.P.				
	1 1" S+W				
			1	7/27/31/79	Labor
				8/2/79	Labor
11-12-98	Inside renewed with			1	3/4" Curb
	35' of 3/4" Copper			9	ft. 3/4" Copper
				1	3/4" Adapter Small
				9	Yds. Gravel
				1	1" Style 138
				1	1" X 5" L.L. Nipple
				1	1" L.L. Coupling
				1	Bag Cement
				1/8	Yd. 1/2" Stone
				1/8	Yd. Brick Sand
				9	Hrs. Trucking
				2	Hrs. Compressor
				1	Hr. Roller
					9' X 14' Long Patch

DATE \_\_\_\_\_

TOWN OF LEXINGTON — BOARD OF PUBLIC WORKS  
WATER DIVISION

Sketch of Service Here

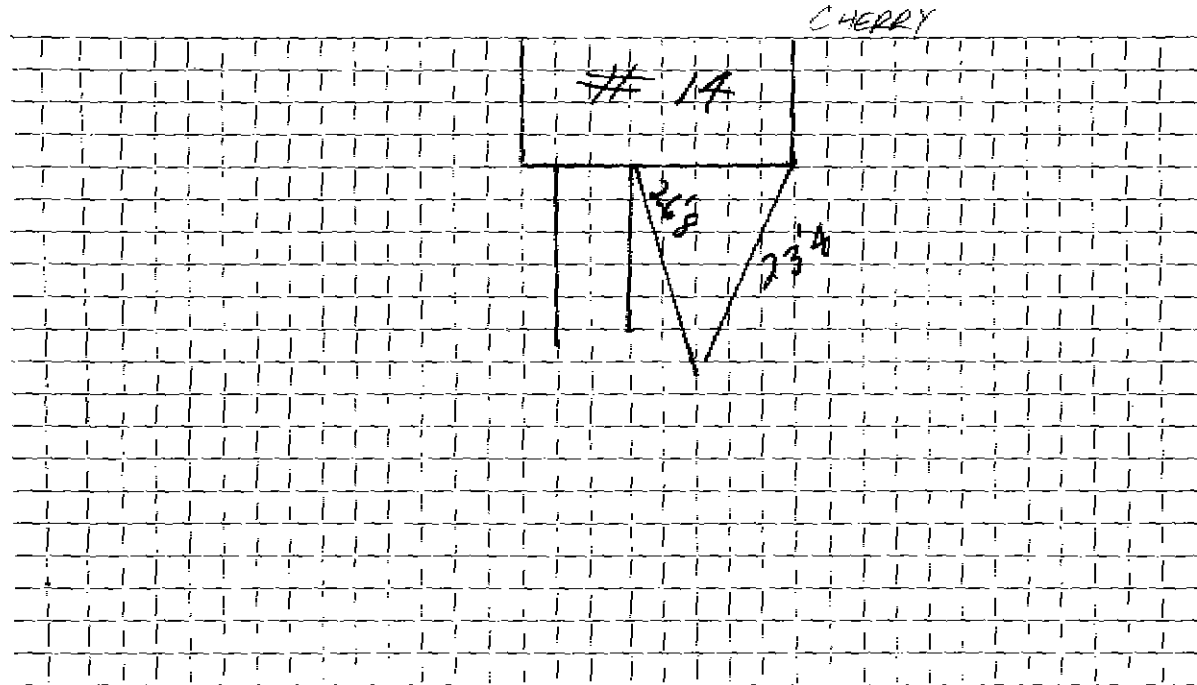

Connection made in ..... Street. Work completed .....

Remarks: ..... Same tie for curb .....