

Name Harry Johnson

Service No. # 557

Address ~~1070 Mass. Ave., Arlington~~  
2 Cherry St.

Location

#2  
Lot 40 - ~~East Ave.~~

Kind of Pipe

Size

Size of Main

Repair—Renewal—New Service

Location

Date	Material	Amount	Total	Date	Amount
10/15/35 <i>Comm. to Renewal</i>	4 hrs. @ 60¢	2 40		Sept 17, 1934	9 50
#1736-12-3-35	43' 1" C.L. Pipe @ 27¢	11 61		June 26, 1936	9 86
	2 1" L.L. Comp. @ 75¢	1 50			<hr/>
	1 1" L.L. Ell	45			19 36
	1 1" Brass Nipple	40			
	1 Stop & Waste	2 00			
	Trucking	1 00			
			\$19 36		
	Labor				

Hadley Press, Inc., Lexington

DATE 1 26 / 1924

# TOWN OF LEXINGTON - BOARD OF PUBLIC WORKS

## WATER DIVISION

The undersigned applies for a supply of water at No. 2 Cherry St and hereby agrees to comply with the rules and regulations as now, or at any future time, established by the Board of Selectmen.

Am't. of Estimate \$ \_\_\_\_\_


Owner Henry E. Johnson

Am't. Paid \$ \_\_\_\_\_

Address 220 Cherry St

Builder \_\_\_\_\_

1200

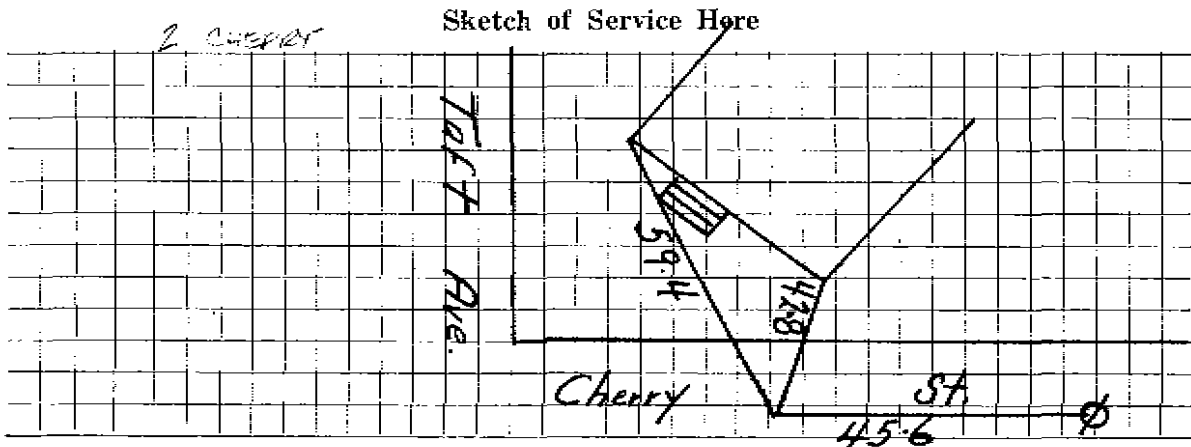

Connection made in \_\_\_\_\_ Street. Work completed \_\_\_\_\_ 19

Remarks:




DATE 12-5-97

TOWN OF LEXINGTON — BOARD OF PUBLIC WORKS

WATER DIVISION

Sketch of Service Here

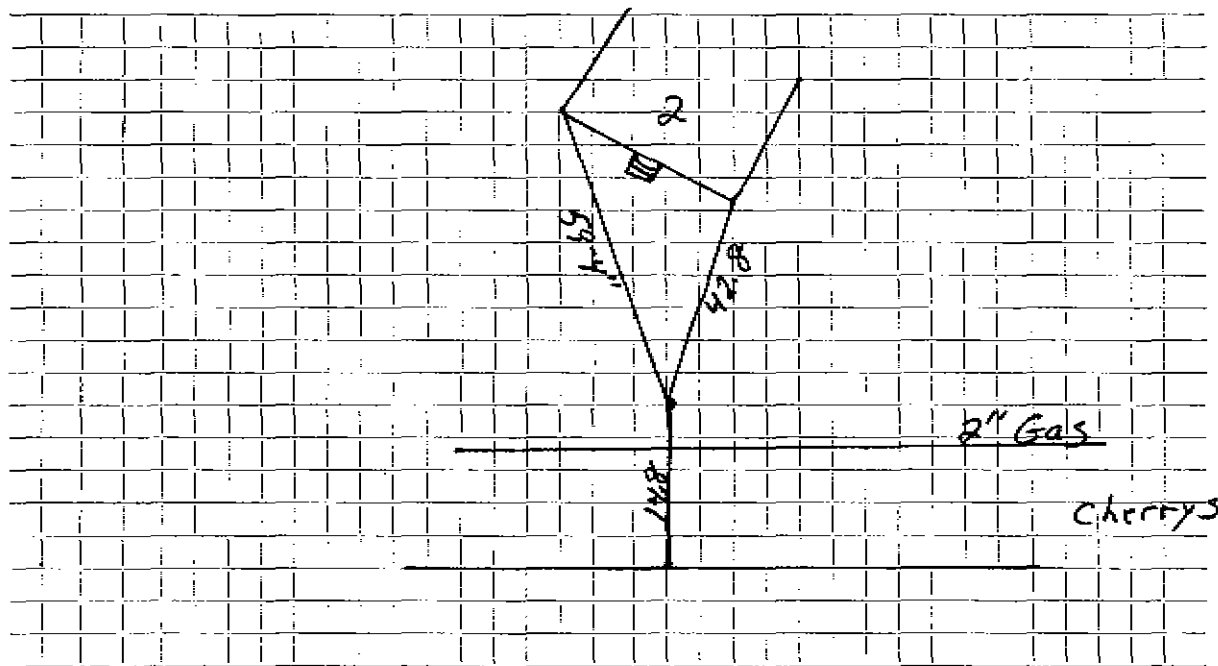

Connection made in ..... Street.

Work completed 10-20-97

Remarks: 2" Gas 4.5" From Curb