

Name Harry E. Johnson

Service No. ~~558~~ 558

Address ~~1070 Mass. Ave., Arlington~~

3889

4 Cherry Street

Location Lot #~~40~~⁴¹ Cherry St. # 4

Kind of Pipe

Size

Size of Main

~~Repair - Renewal~~ - New Service

Location

Date	Material	Amount	Total	Date	Amount
9/3/34	34' 1" C.L. Pipe @ .27	9 18			
12-31-34 Com. 10.80 to Russell	1 1" L.L. Ell.	30			
	1 1" Br. Sp. Nip.	25			
	1 S & W	2 75			
	Trucking	75	\$13 23		
	3 Hrs. Labor @ .60	1 80			
	2 " " @ .55	1 10	2 90		
	10% Overhead		29		
	Total		16 41		
	Charge 36' @ .30	\$10 80	\$10 80		
	Labor				
	Est. of .30 per ft. based on using 3/4" copper tubing, but as no copper tub. was on hand, used c. l. pipe.				
				Aug 25 1934 - Re-painted	10 80
				Checked ct 5-24-05	Outside 3/4 Copper

Hadley Press, Inc., Lexington

DATE Dec 27 1936

TOWN OF LEXINGTON—BOARD OF PUBLIC WORKS

WATER DIVISION

The undersigned applies for a supply of water at No. Lot 4, Cherry St St. and hereby agrees to comply with the rules and regulations as now, or at any future time, established by the Board of Selectmen.

Am't. of Estimate \$ 10.80

Owner


Henry T. Johnson

Am't. Paid \$ 10.80

Address

Builder _____

4 CHERRY

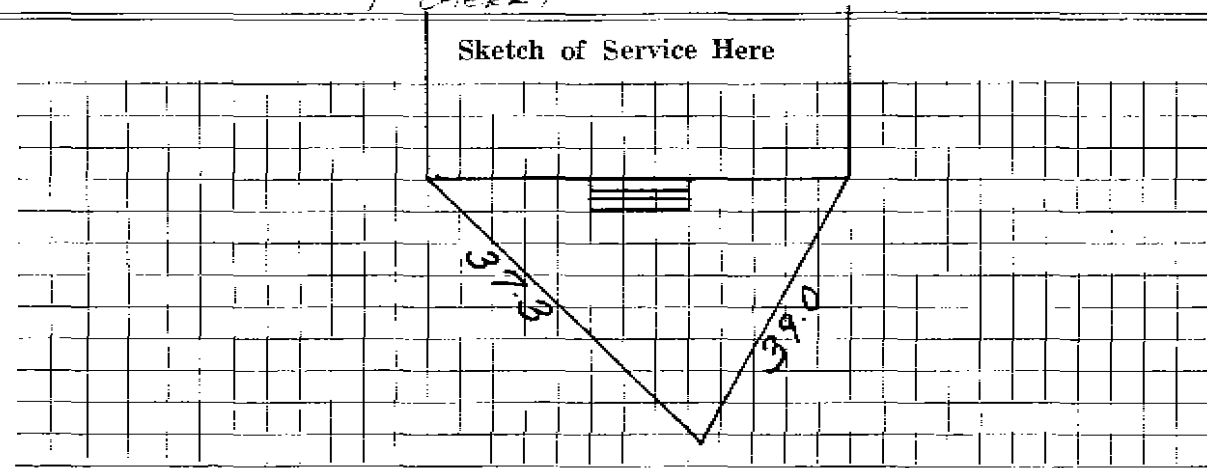

Connection made in _____ Street. Work completed _____ 19

Remarks:

Water 36.4-