

Name John Anderson

Service No. #559

Address ~~54 Tufts Street, Arlington~~
5 Cherry St.

#890

Location 5 Cherry Street

Kind of Pipe

Size

Size of Main

~~Repair—Renewal~~—New Service

Location

Date	Material Chargeable	Amount
5/11/42	1 hr.	60
<i>Del. 7/6/42</i>	1 "	65
	10% overhead	
	34' 3/4" Copper tubing @ 21¢	
	1 3/4" 6x6" I.W.P.S. & W.	
	1 hr. trucking	
Not chargeable (curb to main)		
Labor		6 10
20'	3/4" Cop. tubing @ 21¢	4 20
1	3/4" C.Corp. cock	2 25
1	3/4" C.Curb cock	2 75
1	1/2" offset tail piece	38
1	1/2" slab " "	38
1	Box and rod	1 65
1	hr. trucking	75
		18 46

Total
1 25
13
7 14
2 50
75
<u>11 77</u>

Date

*March 7, 1942 Deposited
Refund*

Amount

20.00
8.23
<u>11.77</u>

DATE March 4, 1942

TOWN OF LEXINGTON—BOARD OF PUBLIC WORKS
WATER DIVISION

The undersigned applies for a supply of water at No. 5 Cherry St. St. and hereby agrees to comply with the rules and regulations as now, or at any future time, established by the Board of Selectmen.

Am't. of Estimate \$ 25.00

Owner

John Anderson

Am't. Paid \$ _____


Address

54 Tufts St Arlington

Builder _____

5 CHERRY

Sketch of Service Here

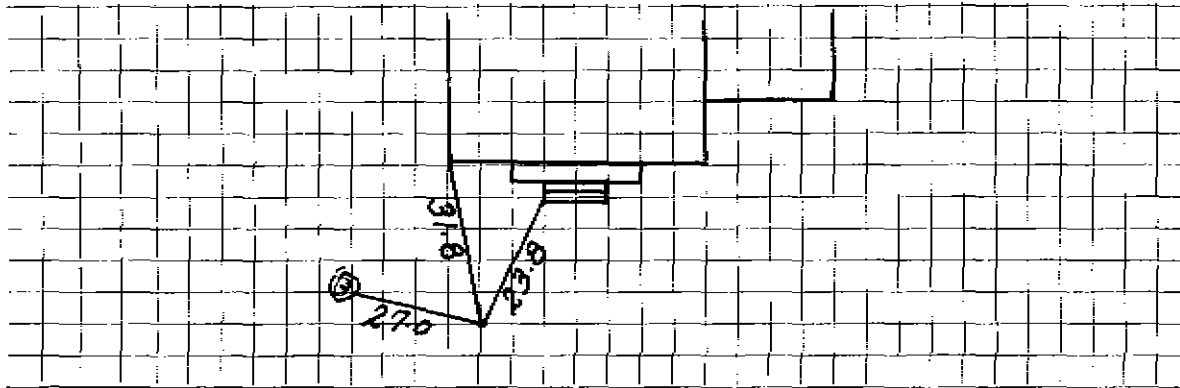

Connection made in _____ Street.

Work completed _____ 19

Remarks: