

Name Ildo Massi

Service No.

3268

Address 7 Cherry Street

Lexington, Mas .

Location 7 Cherry Street

Kind of Pipe

Size

Size of Main

~~Repair~~ ~~Renewal~~ New Service

Location

Date	Material	Amount	Total	Date	Amount
May 26, 1947	Labor	1 05	1 05	May 19, 47	15 00
	10% Overhead		11	Sept 23, 47	1 30
	32' - 3/4" Copper Tubing @.27	8 64	8 64		13 70
	1 - 3/4" C x 1/2" I.W.F. S & W	3 15	3 15	May 26, 1947	1 05
	Trucking 1 hr. @.75	.75	.75	29' - 3/4" Copper Tubing @.27	7 83
			13 70	1 - 3/4" C Corp-cock	3 00
				1 - 3/4" C Curb-cock	3 68
				1 - Box & Rod	4 26
				1 - 1/2" Straight Tail Piece	30
				1 - 1/2" Offset Tail Piece	30
				Trucking 1 hr. @.75	75
					21 17
	Labor				

Deposited
Refunded
Non-Charge

TOWN OF LEXINGTON - BOARD OF PUBLIC WORKS

WATER DIVISION

The undersigned applies for a supply of water at No..... St. and hereby agrees to comply with the rules and regulations as now, or at any future time, established by the Board of Selectmen.

Am't of Estimate \$.....

Owner


Am't Paid \$.....

Address
177 ...

Builder

.....

Sketch of Service Here

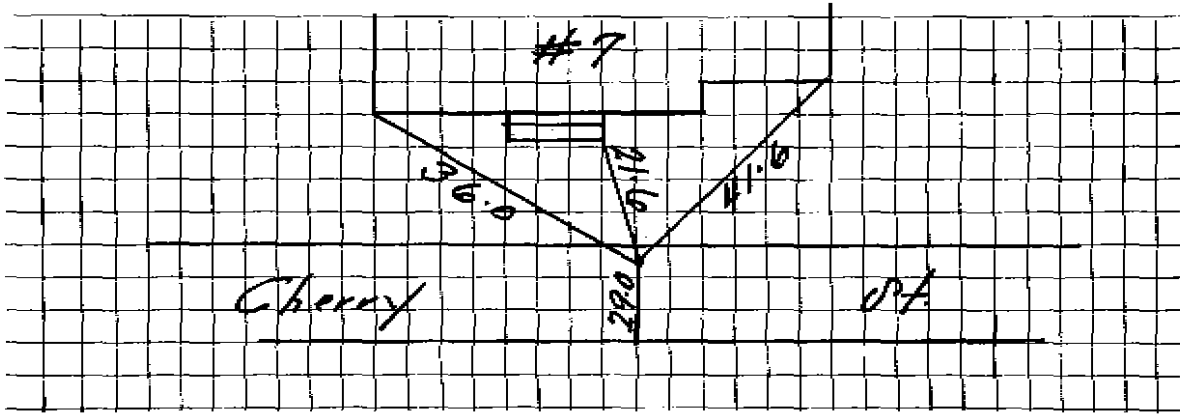

Connection made in Street.

Work completed19

Remarks: