

WATER SERVICE RECORD

Name Marlow McKell

Service No. 154

Address 12 Childs Road

Location

~~Repair/Renewal~~ New Service

Service into curb only

Comm. 10-28-57


Date	Material	Amount	Total	Date	Amount	
8/7/57	Labor	3 91		7-29-57	Deposit	\$ 50 00
	10% overhead	39	4 30	10-28-57	Refund	4 34
89'-3/4"	Copper tubing @.375	33 38			Non Charge	\$ 45 66
1 -3/4"	Cx $\frac{1}{2}$ I W H Stop & Waste	4 96		9/16/55	Labor	1 85
1 -3/4"	C-3 part union	2 27		12'-3/4"	Copper tubing @.56	6 72
1 hr.	trucking @ .75	75	41 36	1-3/4"	C Core cock	4 33
			45 66	1-3/4"	C Curb cock	4 67
					1 Box & Rod	3 90
					1 hr. trucking @.75	75
						22 22
					1 - $\frac{1}{2}$ offset tailpiece	50
					1 - $\frac{1}{2}$ straight tailpiece	50
						23 22

DATE _____

TOWN OF LEXINGTON — BOARD OF PUBLIC WORKS

WATER DIVISION

Sketch of Service Here

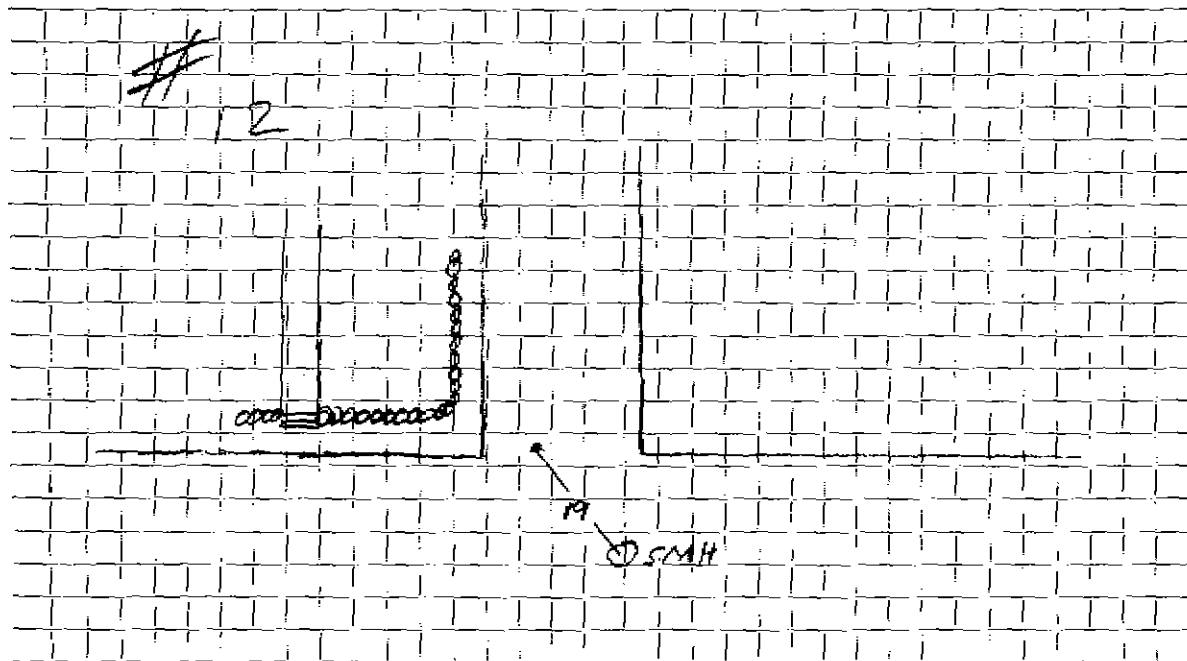

Connection made in Street. Work completed

Remarks:

.....
.....