

4395

WATER SERVICE RECORD

Name Louis Stoico

Service No. 15

Address 14 Childs Road

Location

~~Repair - Renewal~~ - New Service

Comm 5-4-59


Date	Material	Amount	Total	Date	Amount
4-7-59	Labor	2 10		4-1-59	Deposit 25 00
	10% O. H.	21	2 31	5-4-59	Paid by SHC # 8 3 70
54'	3/4" Copper Tubing @.3666	19 80			28 70
1	3/4" C x 1/2 I.W.H. Stop & Waste	5 84			NON CHARGE
1	Hr. Trucking @.75		75	4-7-59	1 1/2 Straight Tailpiece 50
			28 70		1 1/2 Offset Tailpiece 50
					1 00

DATE _____

TOWN OF LEXINGTON — BOARD OF PUBLIC WORKS

WATER DIVISION

Sketch of Service Here

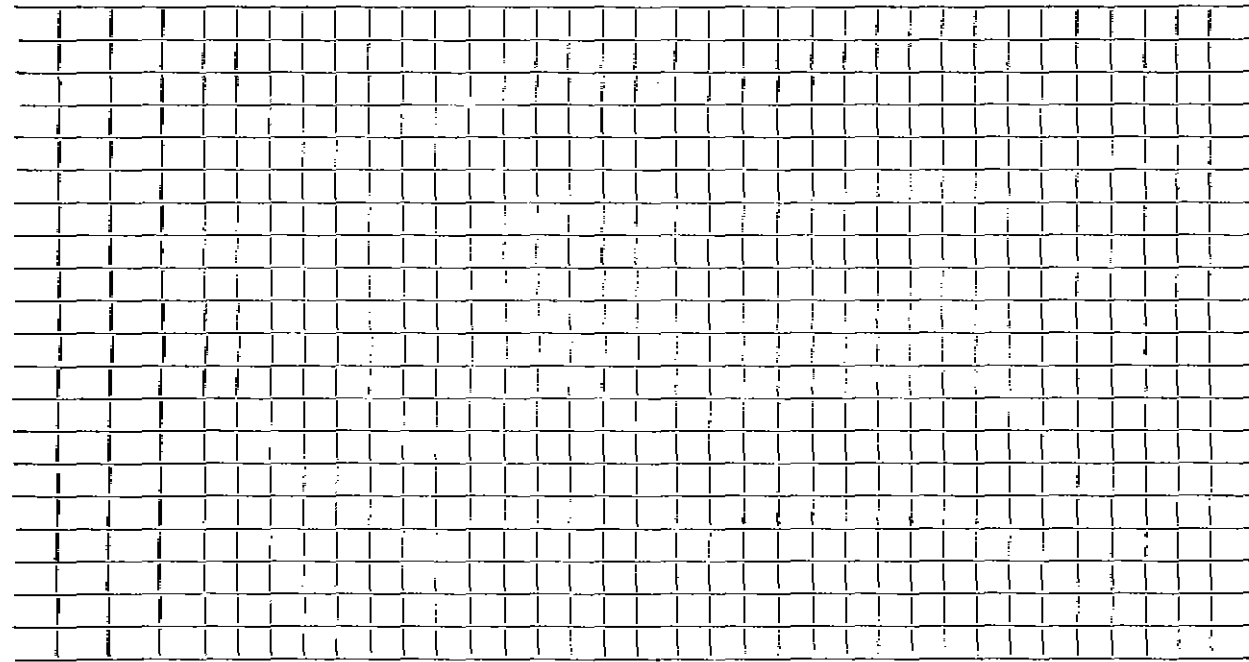

Connection made in Street. Work completed

Remarks:
.....
.....