

WATER SERVICE RECORD

Name Michael Sauligh
 Address #17 Childs Rd.
Lot 5 Childs Road

Service No. 22

AUG 21 1978

Location

#17 Childs Road

~~Repair - Renewal~~ New Service


Trebino #3336

| Date | Material | Amount | Total | Date | Amount |
|---------|------------------------|--------|-------|-----------------------|-------------------|
| 8/22/78 | 60' 3/4" Copper tubing | | | 7-27-78 | 150 00 |
| | | | | | 127 77 |
| | | | | | 22 23 |
| | | | | | <u>NON CHARGE</u> |
| | | | | 6/10/57 | 3 65 |
| | | | | 8' 3/4" Copper tubing | 3 38 |
| | | | | 1 3/4" C Corp Cock | 4 64 |
| | | | | 1 3/4" C Curb Cock | 5 94 |
| | | | | 1 Box & Rod | 4 62 |
| | | | | | <u>22 23</u> |

DATE _____

TOWN OF LEXINGTON — BOARD OF PUBLIC WORKS
WATER DIVISION

Sketch of Service Here

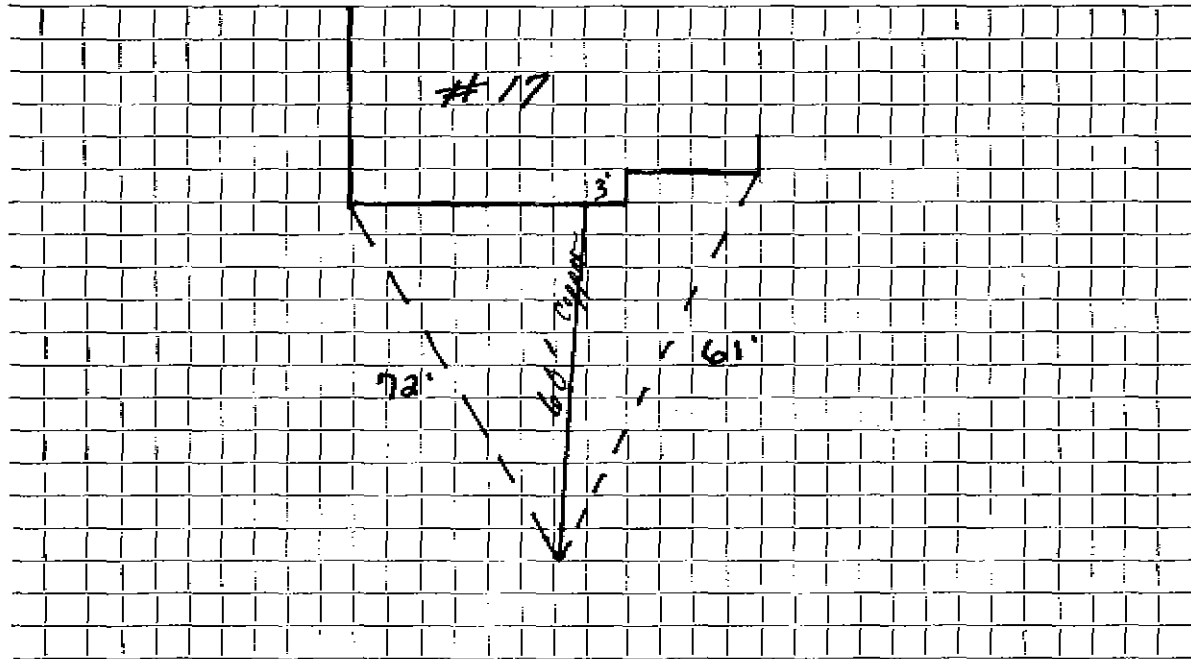

Connection made in Street. Work completed

Remarks:

.....

.....