

WATER SERVICE RECORD

Name Raco Realty TrustService No. 32Address #20 (Lot 3) Childs Road# 4620

Location

~~Repair - Remodel~~ New ServiceComm 8-4-58


Date	Material	Amount	Total	Date	Amount
4-7-58	Labor	3.52		3-31-58	Deposit 50.00
	10% overhead	.35	3.87	8-4-58	Refund 26.07
	55' 3/4" Copper tubing @.37		20.35		29.93
	1 3/4" C x 1/2" I.W.H. Stop & Waste		4.96		<u>NON CHARGE</u>
	1 hrs. Trucking @.75		.75	6/10/57	Labor 3.65
			29.93		22' 3/4" Copper tubing @.4228 9.30
					1 3/4" C Corp Cock 4.64
					1 3/4" C Curb Cock 5.94
					1 Box & Rod 4.62
					<u>28.15</u>
					1 1/2 Straight tailpiece .50
					1 1/2 Offset tailpiece .50
					<u>29.15</u>

DATE _____

TOWN OF LEXINGTON — BOARD OF PUBLIC WORKS

WATER DIVISION

Sketch of Service Here

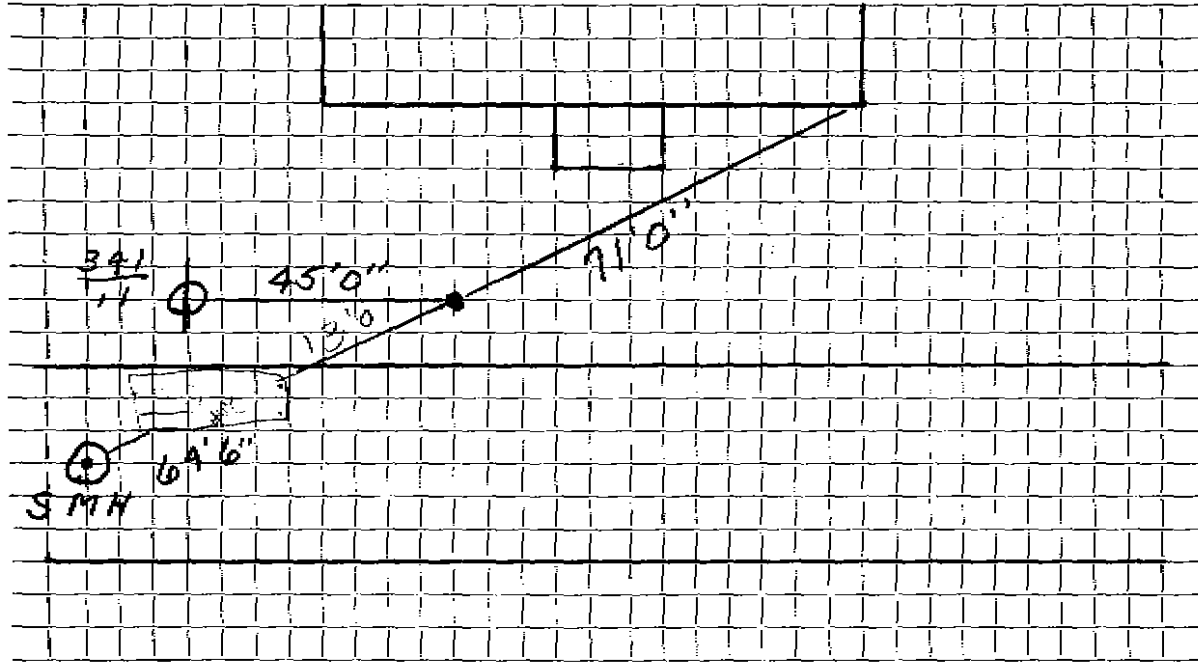

Connection made in Street. Work completed

Remarks:
.....
.....