

WATER SERVICE RECORD

Name Arthur G. Mitchell

Service No. 75

Address 6 Childs Road

2517

Location


Repair—Renewal—New Service

Date	Material	Amount	Total	Date	Amount	
4/30/56	Labor	5 70		4-18-56	Deposit	\$ 50 00
	10% overhead	57	6 27	8-20-56	Pay	7 57
	94' 3/4" copper tubing @.4850		45 59		<u>NON CHARGE</u>	7 57 57
	1 - 3/4" C x 1/2 I.W.H. stop&waste		4 96	1 1/2 straight tail piece		50
	1 hr. trucking @.75		75	1 1/2 offset tail piece		50
			57 57			1 00
				9/16/55	Labor	1 85
				28'	3/4" Copper tubing @ .56	15 68
				1	3/4" C Corp Cock	4 33
				1	3/4" C Corb Cock	4 67
				1	Box & Red	3 90
				1	hr. trucking @ .75	75
						31 18

DATE _____

TOWN OF LEXINGTON — BOARD OF PUBLIC WORKS
WATER DIVISION

Sketch of Service Here

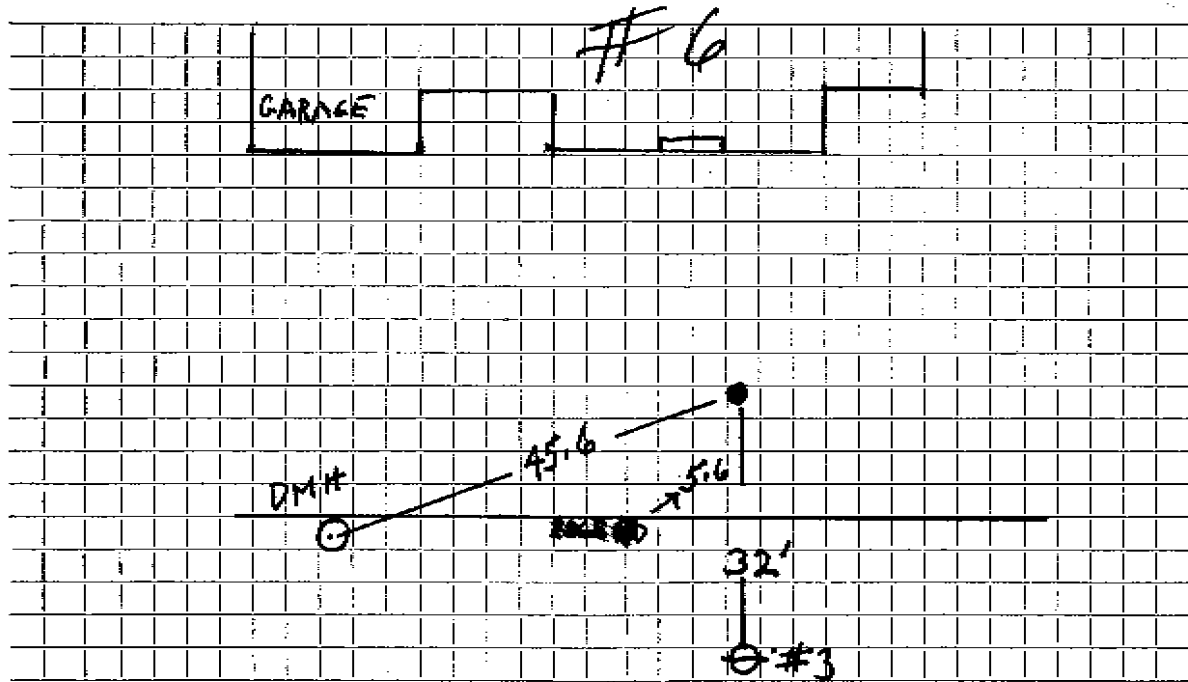

Connection made in Street. Work completed

Remarks:
.....
.....