




DATE \_\_\_\_\_

TOWN OF LEXINGTON — BOARD OF PUBLIC WORKS

WATER DIVISION

Sketch of Service Here

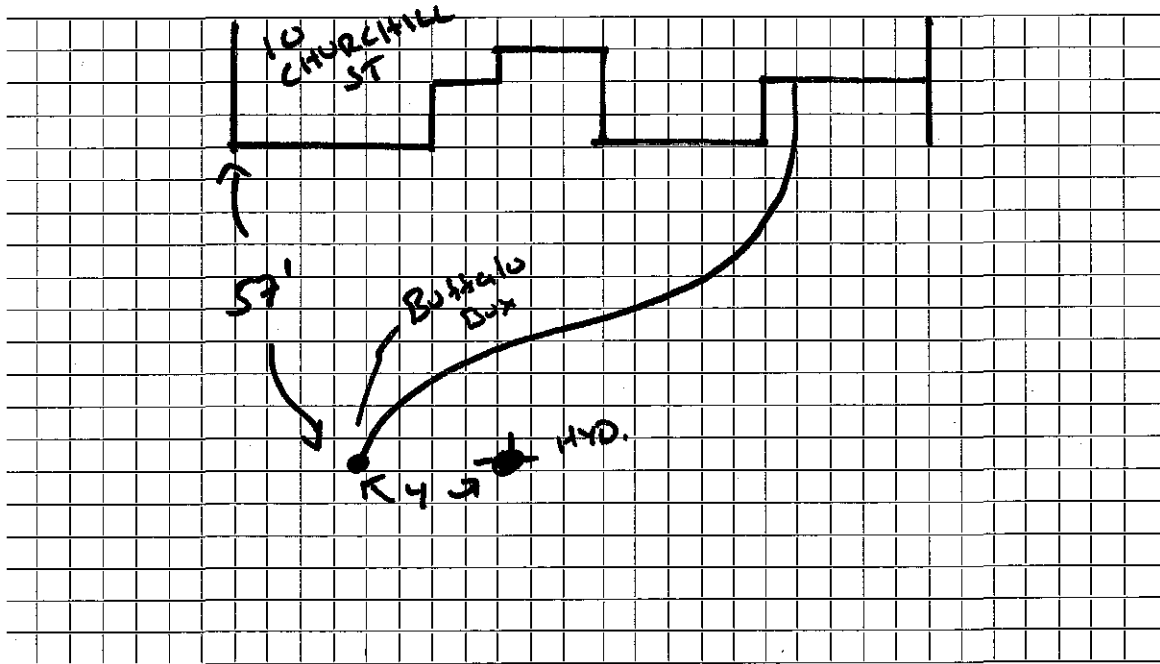

Connection made in CHURCHILL Street. Work completed IOVINO

Remarks: .....

.....

.....