


DATE _____

TOWN OF LEXINGTON — BOARD OF PUBLIC WORKS

WATER DIVISION

Sketch of Service Here

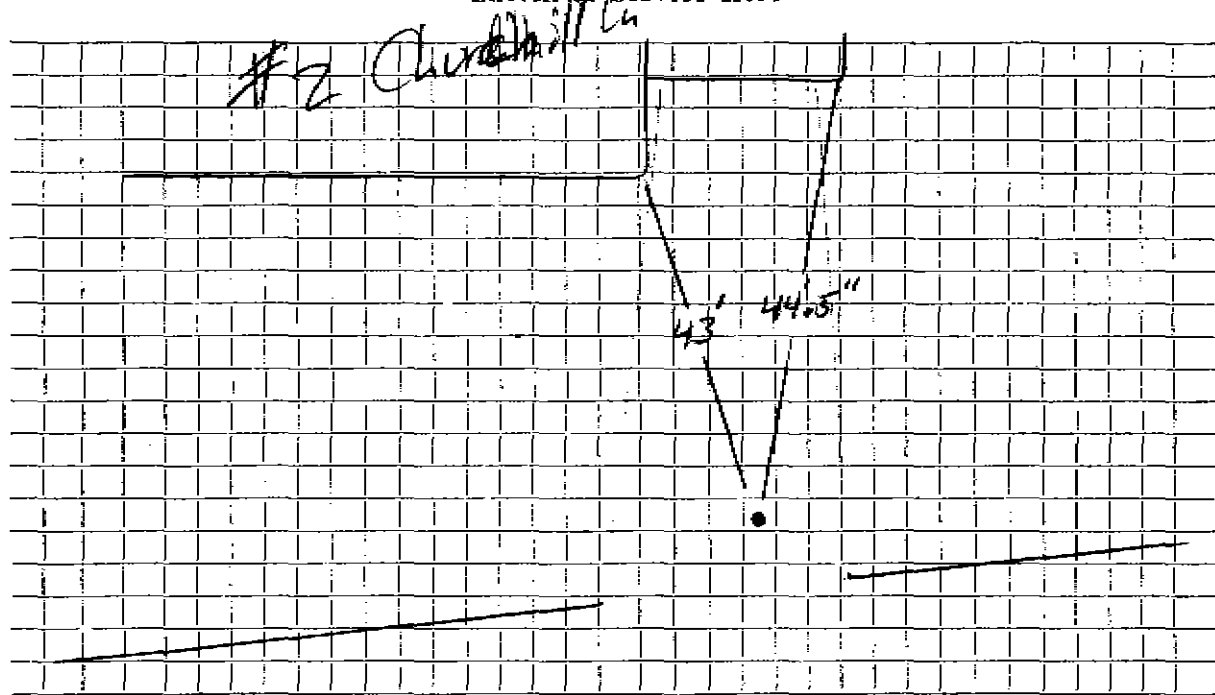

Connection made in Church Hill Ln Street. Work completed

Remarks: #1 on house

.....
.....