

WATER SERVICE RECORD

Name F. A. Currier

Service No. 331

Address 4 Churchill Lane

# 4592

Location Lexington, Mass.

Repair or Renewal - New Service


Com. 12-26-50

Date	Material	Amount	Total	Date	Amount
Nov. 9, '50	Labor	2 92	2 92	Oct 24, 50	Deposited 50 00
	10% Overhead		29		
	45' - 3/4" Copper Tubing @ .32	14 40	14 40		No Charge 43 12
	1 - 3/4" C x 1/2" I.W.H. S&W	3 76	3 76	Nov. 9, '50	Labor 2 92
	Littlefield Shovel 2 hrs. @ 7.00	14 00	14 00		15' - 3/4" Copper Tubing @ .32 4 80
	Trucking 1 hr. @ .75	.75	75		1 - 3/4" Corp-cock 3 60
	Patching 7 x 3		7 00		1 - 3/4" C x 3/4" C Curb-cock 4 40
			43 12		1 - Box & Rod 3 35
					1 - 1/2" Offset Tail Piece 42
					1 - 1/2" Straight Tail Piece 42
					Littlefield Shovel 2 hrs. @ 7.00 14 00
					Trucking 1 hr. @ .75 75
					34 66

DATE \_\_\_\_\_

**TOWN OF LEXINGTON — BOARD OF PUBLIC WORKS**  
**WATER DIVISION**

Sketch of Service Here

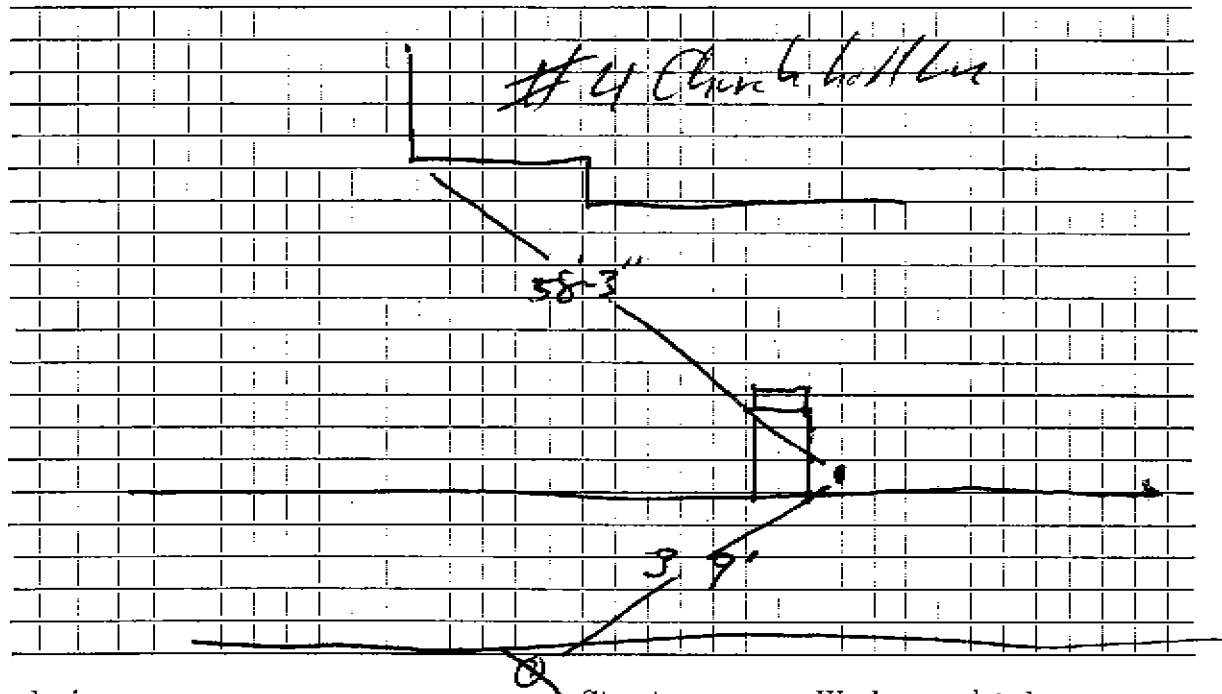

Connection made in ..... Street. Work completed .....

Remarks: .....  
.....  
.....