

Name Frank J. Balduzzi

Service No. 191

Address 7 Churchill Lane

Lexington, Mass.

Location 7 Churchill Lane

Kind of Pipe

Size

Size of Main

~~REPAIR-CHARGE~~ - New Service

Com. 11-6-50

Location

Date	Material	Amount	Total	Date	Amount
Aug. 2, '50	Labor	2 75	2 75	July 28 '50	60 00
	10% Overhead		28	7/16 '50	3 12
	54' - 3/4" Copper Tubing @.23		12 42		56 88
	1 - 3/4" C x 1/2" I.W.H. S&W		3 29	Aug. 2, '50	1 85
	1 - 3/4" C x 3/4" C Union (3pts)		1 39	Aug. 3, '50	6 60
	Littlefield Shovel 3 hrs. @ 7.00		21 00	27' - 3/4" Copper Tubing @.23	6 21
	Trucking 1 hr. @ .75		75	1 - 3/4" C Corp-cock	3 15
	Patching 15 x 3		15 00	1 - 3/4" C x 3/4" C Curb-cock	3 85
			56 88	1 - Box & Rod	3 35
				1 - 1/2" Offset Tail Piece	42
				1 - 1/2" Straight Tail Piece	42
				Littlefield Shovel 3 1/2 hrs. @ 7.00	24 50
	Labor			Trucking 1 hr. @ .75	75
					51 10

*Separated  
Estimated  
No Charge*

Hadley Press, Inc., Lexington

DATE \_\_\_\_\_

# TOWN OF LEXINGTON—BOARD OF PUBLIC WORKS

## WATER DIVISION

The undersigned applies for a supply of water at No. \_\_\_\_\_ St. and hereby agrees to comply with the rules and regulations as now, or at any future time, established by the Board of Selectmen.

Am't. of Estimate \$ \_\_\_\_\_


Owner \_\_\_\_\_

Am't. Paid \$ \_\_\_\_\_

Address \_\_\_\_\_

Builder \_\_\_\_\_

Sketch of Service Here

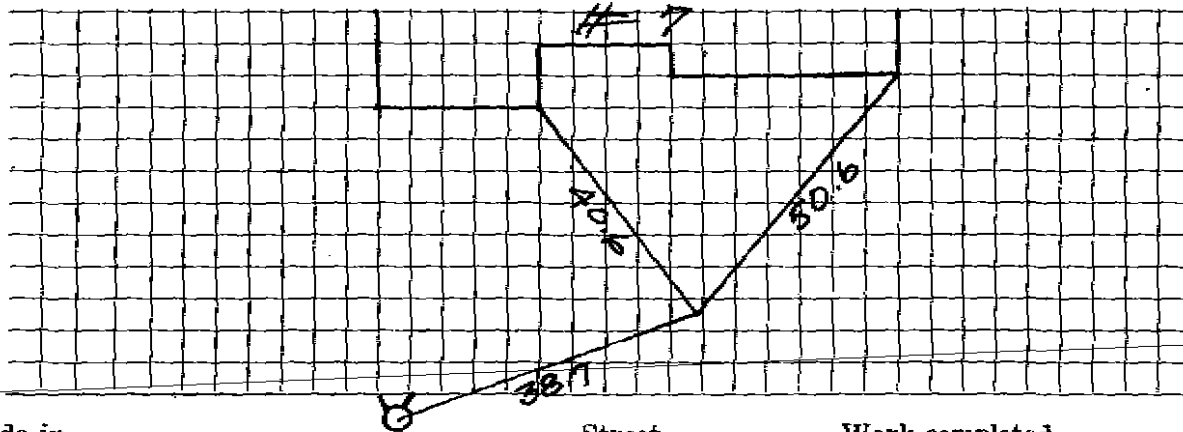

Connection made in \_\_\_\_\_ Street.

Work completed \_\_\_\_\_ 19

Remarks: