

Name A. J. Comeau
 Address 8 Churchill Lane
 Lexington, Mass.

Service No. 204

Location 8 Churchill Lane

Kind of Pipe

Size

Size of Main

~~Repair~~ ~~Renewal~~ - New Service

Com. 11-6-50

Location

Date	Material	Amount	Total	Date	Amount
Aug. 21, '50	Labor	2 75	2 75	Aug 4 '50	60 00
	10% Overhead		28	7-4-50	10 04
	60' - 3/4" Copper Tubing @.275	16 50			49 96
	1 - 3/4"C x 1/2" I. V. H. S&W	3 29		Aug. 21, '50	Labor
	1 - 3/4"C x 3/4"C Union (3pts)	1 39			2 75
	Littlefield Shovel 3 hrs. @7.00	21 00			8' - 3/4" Copper Tubing @.275
	Trucking 1 hr. @.75	75			2 20
	Patching 4 x 3	4 00			1 - 3/4"C Corp-cock
		49 96			3 15
					1 - 3/4"C x 3/4"C Curb-cock
					3 85
					1 - Box & Rod
					3 35
					1 - 1/2" Offset Tail Piece
					38
					1 - 1/2" Straight Tail Piece
					38
					Littlefield Shovel 2 hrs. @ 7.00
					14 00
					Trucking 1 hr. @.75
					75
	Labor				30 81

Supported
Revised
 No Charge

Hadley Press, Inc., Lexington

DATE _____

TOWN OF LEXINGTON—BOARD OF PUBLIC WORKS

WATER DIVISION

The undersigned applies for a supply of water at No. _____ St. and hereby agrees to comply with the rules and regulations as now, or at any future time, established by the Board of Selectmen.

Am't. of Estimate \$ _____


Owner _____

Am't. Paid \$ _____

Address _____

Builder _____

Sketch of Service Here

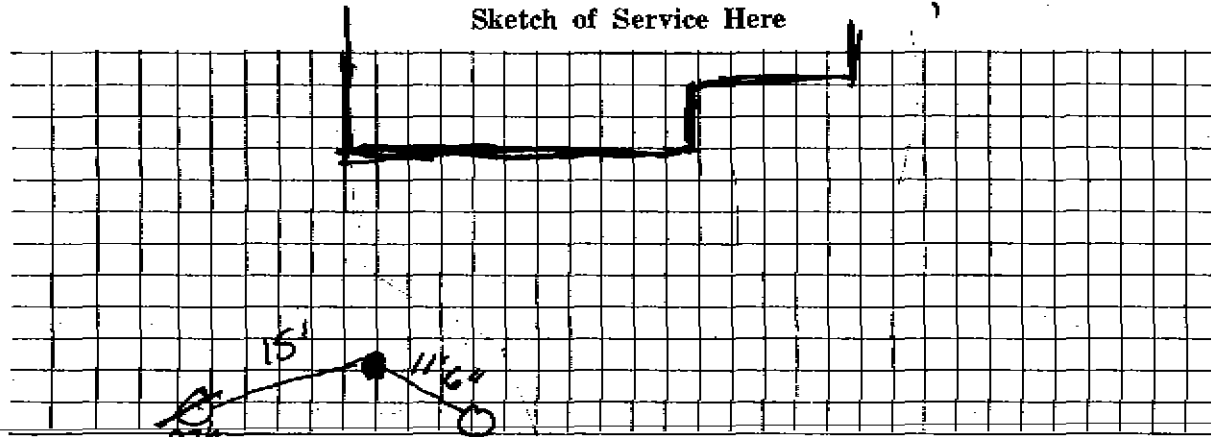

Connection made in 206/5 Street.

Work completed _____ 19

Remarks:

Name A. J. Comeau

Service No. 204

Address 8 Churchill Lane

Lexington, Mass.

Location 8 Churchill Lane

Kind of Pipe

Size

Size of Main

~~Repair - Renewal~~ - New Service

Com. 11-6-50

Location

Date	Material	Amount	Total	Date	Location	Amount
Aug. 21 '50	Labor	2 75	2 75	Aug 4 '50	Proposed	60 00
	10% Overhead		28	Pr 4 '50	Revised	10 04
	60' - 3/4" Copper Tubing @.275	16 50	16 50		No Charge	49 96
	1 - 3/4" C x 1/2" I.W.H. S&W	3 29	3 29	Aug. 21, '50	Labor	2 75
	1 - 3/4" C x 3/4" C Union (3pts)	1 39	1 39	8' - 3/4" Copper Tubing @.275		2 20
	Littlefield Shovel 3 hrs. @7.00	21 00	21 00	1 - 3/4" C Corp-cock		3 15
	Trucking 1 hr. @.75	75	75	1 - 3/4" C x 3/4" C Curb-cock		3 85
	Patching 4 x 3	4 00	4 00	1 - Box & Rod		3 35
			49 96	1 - 1/2" Offset Tail Piece		38
				1 - 1/2" Straight Tail Piece		38
				Littlefield Shovel 2 hrs. @ 7.00		14 00
				Trucking 1 hr. @.75		75
	Labor					30 81

DATE _____

TOWN OF LEXINGTON—BOARD OF PUBLIC WORKS

WATER DIVISION

The undersigned applies for a supply of water at No. _____ St. and hereby agrees to comply with the rules and regulations as now, or at any future time, established by the Board of Selectmen.

Am't. of Estimate \$ _____


Owner _____

Am't. Paid \$ _____

Address _____

Builder _____

Sketch of Service Here

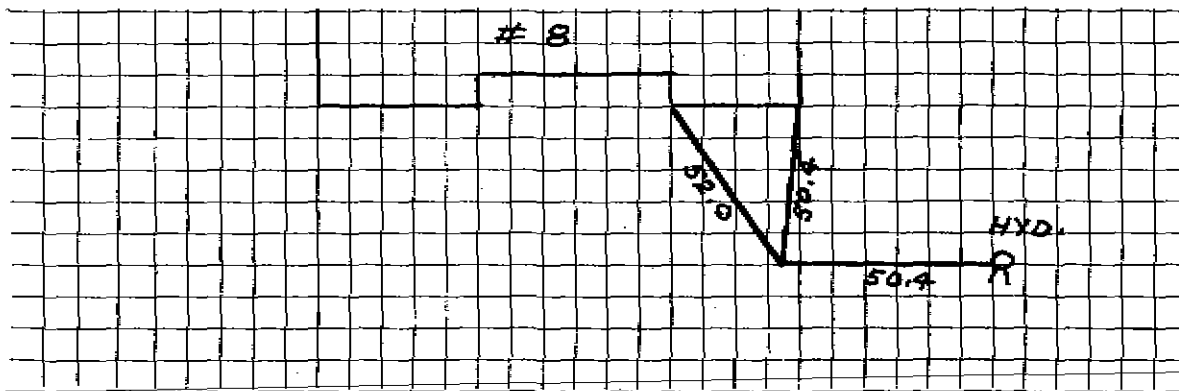

Connection made in _____ Street.

Work completed _____ 19

Remarks: