


DATE July 2003

TOWN OF LEXINGTON — BOARD OF PUBLIC WORKS
WATER DIVISION

Sketch of Service Here

LOT 3

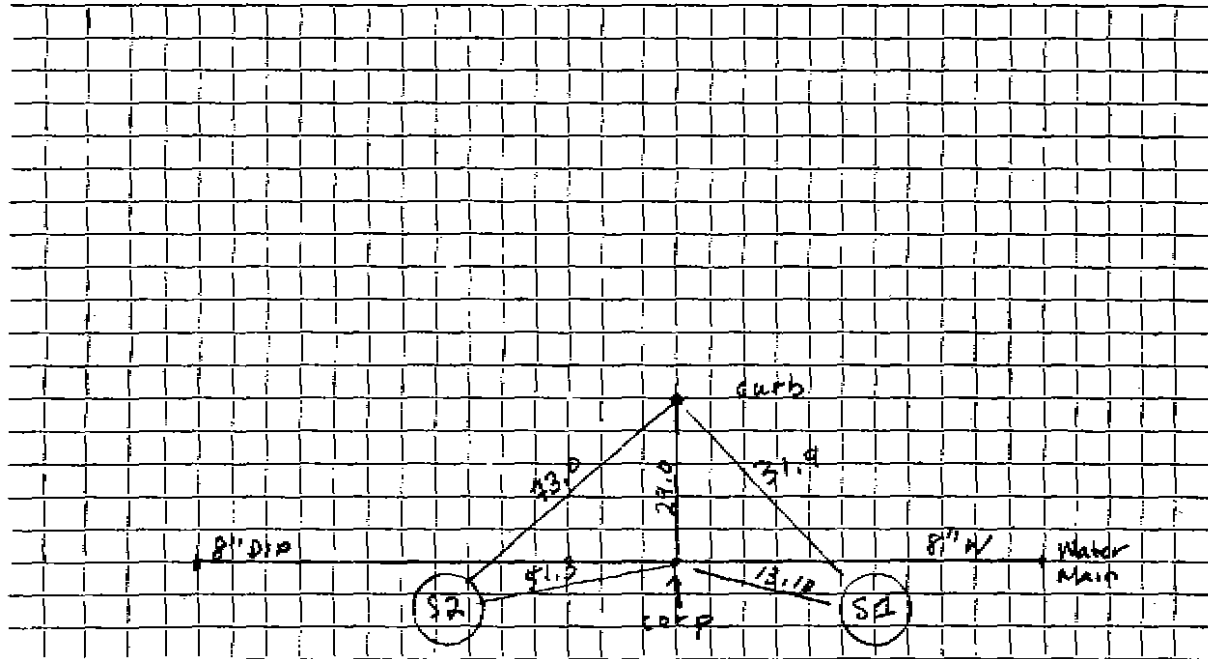

Connection made in Street. Work completed

Remarks:

.....

.....