




DATE July 2003

TOWN OF LEXINGTON — BOARD OF PUBLIC WORKS

WATER DIVISION

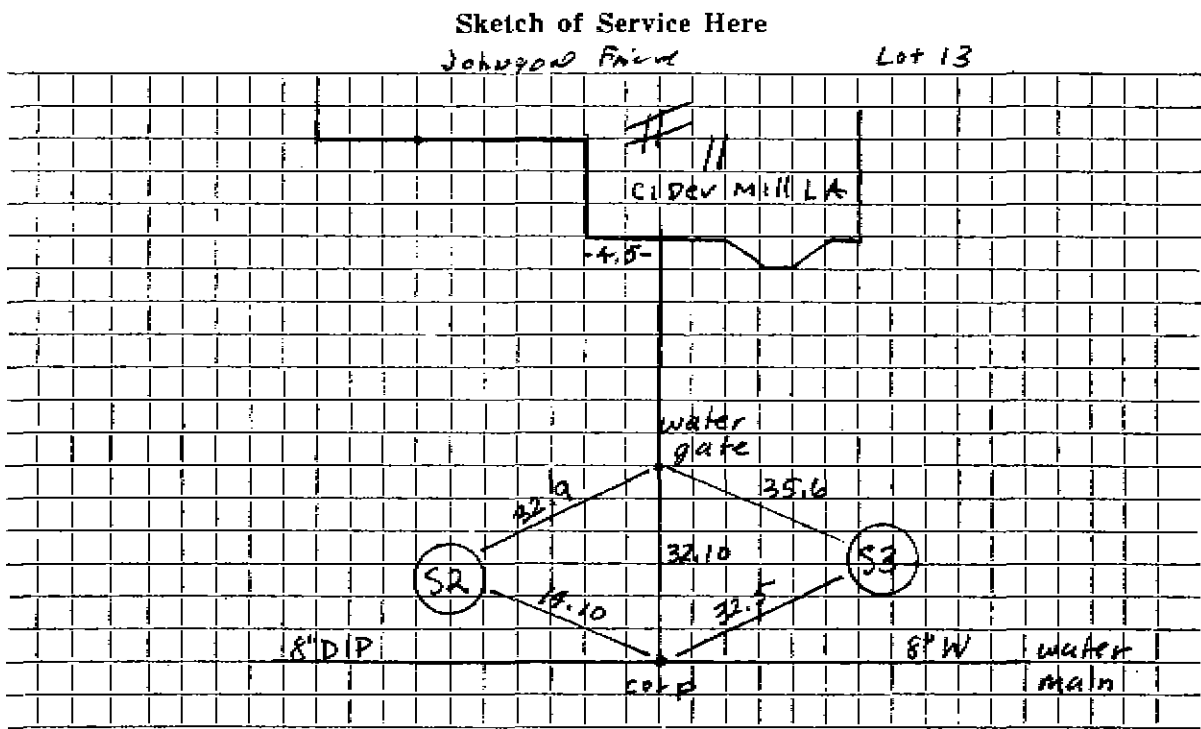

Connection made in ..... Street. Work completed .....

Remarks: .....  
.....  
.....