


DATE _____

TOWN OF LEXINGTON — BOARD OF PUBLIC WORKS

WATER DIVISION

Sketch of Service Here
LOT-1

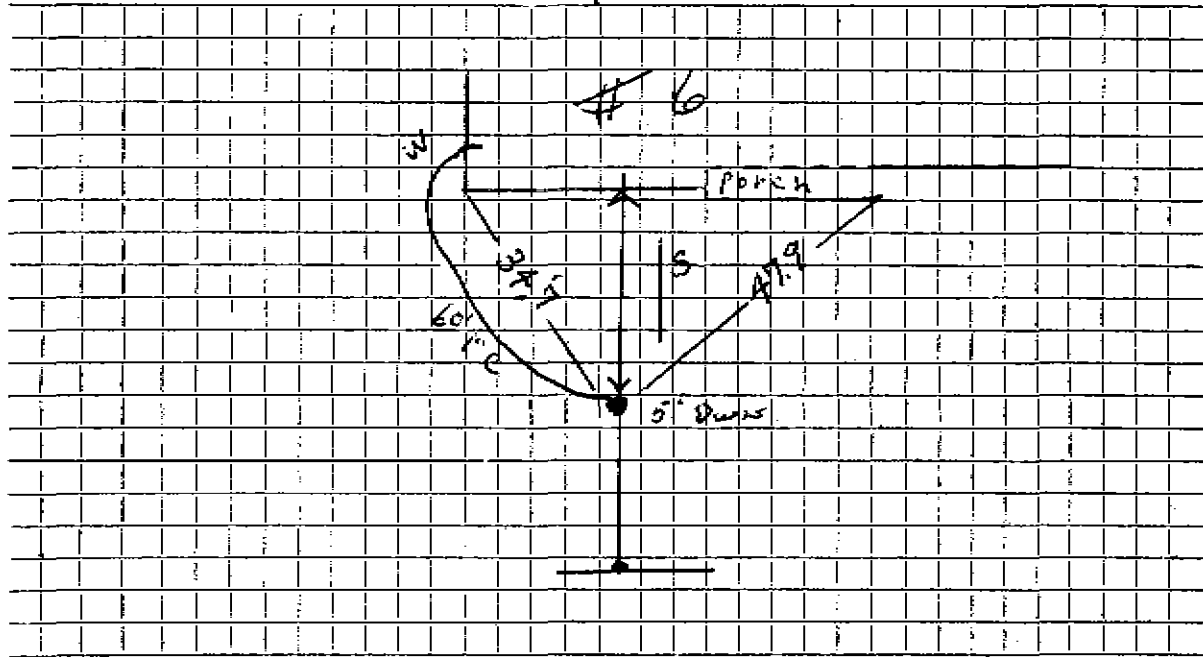

Connection made in Street. Work completed 9/24/03

Remarks: Dave P. Insp.