




DATE July 2003

TOWN OF LEXINGTON — BOARD OF PUBLIC WORKS  
**WATER DIVISION**

Sketch of Service Here

LOT 2

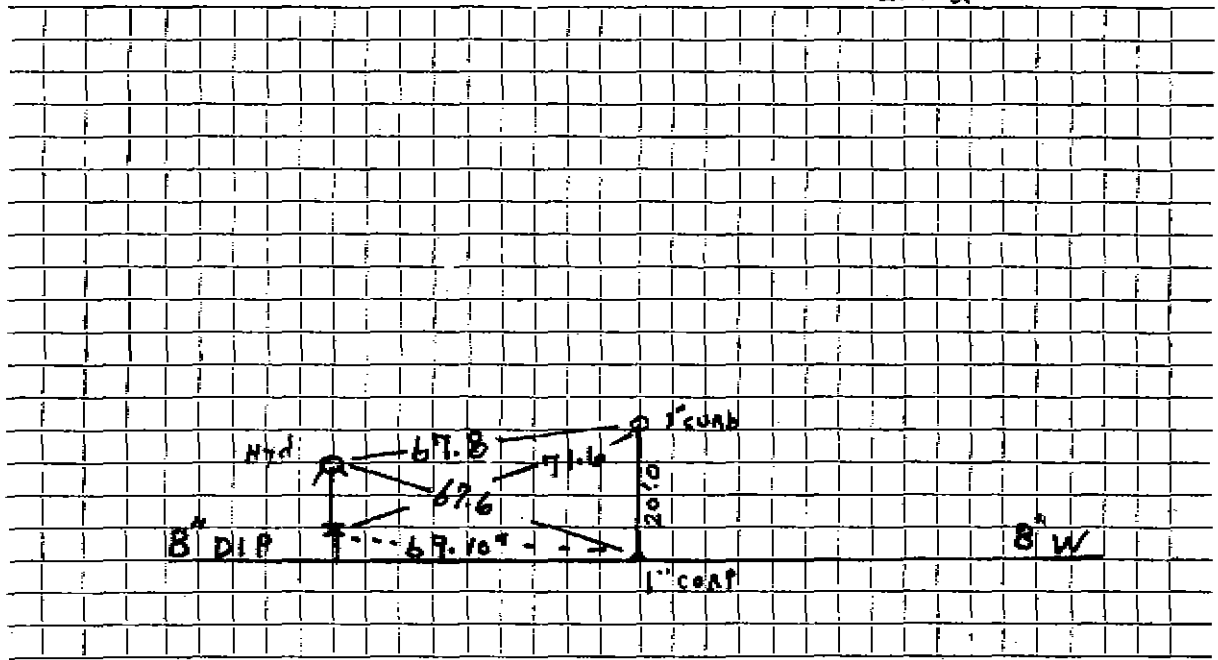

Connection made in ..... Street. Work completed July 2003

Remarks: .....  
.....  
.....